

LAND CORNER RECORDATION CERTIFICATE
Filing Requirement of Act 74, Mich. P.A. 1970

For corners in Paw Paw Township

<u>Van Buren</u> (County)	Located In:	Corner Code #
1. Public Land Survey S 1/4 Post, Sec 14	T <u>3S</u> R <u>14W</u> T ___ R ___ T ___ R ___ T ___ R ___	<u>57</u> _____ _____ _____
2. Property Controlling in Section	S ___ T ___ R ___ S ___ T ___ R ___	_____ _____
3. Miscellaneous Property in Sec.	S ___ T ___ R ___ S ___ T ___ R ___	_____ _____

FILED

Oct 30 10 39 AM '98

Mark A. Smith
VAN BUREN CO. REGISTERED PROFESSIONAL SURVEYOR
 Liber 5 Page 104

Register of Deeds Stamp & File Number

10/30 0105 10SURVEY

4. Lot No. _____, Recorded Plat _____
 5. Private Claims _____

I, Donald R. Gilchrist in a field survey on Oct. 5, 1998 do hereby state that under requirements of P.A. 74, Michigan P.A. of 1970, the corner points mentioned in lines 1 and 2 above were in conformance with regulations and rules therefore as required in the current manual of survey instructions of the United States Department of the Interior, Bureau of Land Management or by a decree of a Court of Law and /or that the corner points mentioned in lines 3, 4 and 5 above were in conformance with the rules of the Michigan Board of Land Surveyors or by a Decree of a Court of Law; established, re-established, monumented, recovered, found as expressed below:

NOTE: Not more than 2 corners, all in the same town and range, may be recorded on this certificate.

A	B	C	D	E	F	G	H	I	J	K	L	M
1												
2	6	5	4	3	2	1						
3												
4	7	8	9	10	11	12						
5												
6	18	17	16	15	14	13						
7												
8	19	20	21	22	23	24						
9												
10	30	29	28	27	26	25						
11												
12	31	32	33	34	35	36						
13												

A. Description of original monument and accessories and/or subsequent restoration:

1827 - GOVERNMENT - William Brookfield, D.S.
 West along corrected line between Sections 14 and 23 a distance of 40.075 chs. (2644.95').
1910 +- - Chessey Railroad Plans.
 Section 14
 Show a distance of 2598.0' to South Quarter Post.
 Distance between centerline of Railroad and Center Quarter Post is 66.54'.
 Total distance between Center Quarter Post and South Quarter Post is 2664.54'.
 (Continued on back of Certificate)

B. Description of corner evidence found and/or method applied in restoring or reestablishing corner:

Found spike 3' S of Centerline of Road - Determining to be in wrong location, set Harrison Marker 28' N on 1/4 Line from this point. Approved at the 2/25/98 Van Buren County Peer Group Meeting and is the best available evidence.

Ratified by Peer Group in
 accordance with P.A. 345 of 1990
 Van Buren County Surveyor

Date D. R. G. 10-30-98

C. Description of monument for corner and accessories established to perpetuate locating the position of the corner:


Harrison Marker/Survey Marker Post 1' North.
 14" Maple - S 15° W - 49.55' Nail in West side.
 10" Hickory - South 56.53' Nail in West side.
 24" Maple - S 20° E 73.78' Nail in East side.
 Centerline of Road - 25' South.
 Spike 28' S on extension of 1/4 Line.

**SURVEY &
 REMONUMENTATION**

JAN 11 1999

SECTION

Signed by Donald R. Gilchrist
 Surveyor's Michigan License No. RLS 13583

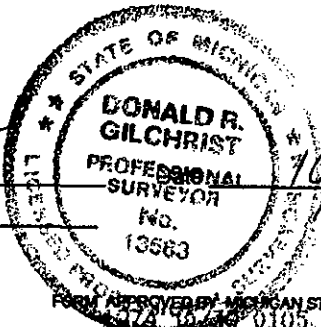

1956+- - W. Q. Smith, C.S.

Section 14

Note - Shows setting corner in centerline of road and on fence line North.

1957 +- - Note - Found corner in centerline gravel road.

1957+- - Worksheet - Shows distance from North Quarter Post to South Quarter Post of 5315.32'.

12/4/1970 - Notes - Show tie to concrete fence post 28' North of existing point.

6/9/1971 - Recordation Certificate (Liber 1 - Page 70).

Found 3/4" pipe in centerline of East & West Road.

Witnesses:

10" Maple - 24.82' - S 30° W.

12" Ash - N 1° E - 30.12'.

12" Twin Maple - N 20° W - 35.0'.

10/6/1971 - Notes - Show traverse to South Quarter Post.

Section 23

1/1972 - Drawing shows distance of N 87° 25' 15" W 2654.80' to stone.

Distance S 88° 21' 42" E 2680.52' to Section Corner.

Distance North 1° 1' 00" E 2695.84' to Center Quarter Post.

Distance South 0° 57' 8" W 2604.52' to Center Quarter Post.

2/9/1972 - Note - Ties to North Quarter Post for Paw Paw Treatment Plant.

3/14/1972 - Note - Ties to North Quarter Post in monument box for Paw Paw Treatment Plant.

4/6/1972 - Recorded Drawing (Liber 1 - Page 318) shows corner and witnesses (same as above), distance West is 2654.8'.

Distance South is 2604.52' to Quarter Post.

10/27/1972 - Recorded Drawing (Liber 3 - Page 73) same as above.

11/22/1972 - Recorded Drawing (Liber 3 - Page 107) same as above.

9/25/1974 - Francis Spicer, R.L.S.

Same as above.

12/15/1981 - Gove Associates

Notes - Show tie to Quarter Post.

12/1997 - Statement by Judith Brockway Haefner.

See Statement

Copy of Brockway deed to Road Commission.

2/1998 - Statement by party chief Charles Lossie.

Reporting work on corner.

SURVEY &
REMONUMENTATION

JAN 11 1999

SECTION