

COMMISSION VAN BUREN COUNTY REMONUMENTATION PROGRAM

LIBER 4 PAGE 52

LAND CORNER RECORDATION CERTIFICATE
Filing Requirement of Act 74, Mich. P.A. 1970

OCT 19 11 52 AM '93

For corners in

Form with fields for County (Van Buren County), Located In (Paw Paw Twp.), Corner Code (# K-3), and survey details (Public Land Survey Sec. 1 T 3 S. R 14 W.).

Handwritten signature: Mark A. Smith, VAN BUREN CO REGISTER OF DEEDS

Register of Deeds Stamp & File Number

- 4. Lot No.
5. Private Claims

Grid table with columns A-K and rows 1-13. A dot is marked at the intersection of column K and row 3.

I, John C. Hunt, P.S. in a field survey on Oct. 15, 1993, do hereby certify that under requirements of P.A. 74, Michigan P.A. of 1970, the corner points mentioned in lines 1 and 2 above were in conformance with regulations and rules therefore as required in the current manual of survey instructions of the United States Department of the Interior, Bureau of Land Management or by a decree of a Court of Law and/or that the corner points mentioned in lines 3, 4 and 5 above were in conformance with the rules of the Michigan Board of Land Surveyors or by a Decree of a Court of Law; established, re-established, monumented, re-monumented, recovered, found as expressed below:

NOTE: Not more than 4 corners, all in the same town and range, may be recorded on this certificate.

A. Description of original monument and accessories and/or subsequent restoration:

5/1830 Gov. Survey: Wm. Brookfield DS, Set post corner. Wit.: 24" White Oak S.61°E. 7 lks. (4.62'); 10" White Oak N.37°W. 34 lks. (22.44'); meas. W. 40.07 ch & meas. E. 40.43 ch. 5/21/1900 G. Mutchler CS, fd. stone & stake & re-wit.: 20" Sugar SW 51.5 lks. (33.99') & 12" Sugar NW 52.5 lks. (34.65'); meas. W. to 1/4 post 40.695 ch. (2685.87'). 1900+ WH Goss CS, red bk.: meas. W. to 1/4 post 40.67 ch (2684.22'), meas. S. to 1/8 post 20.12 ch (1327.92'). 5/1923 TA Smith CS, red bk.: fd. decayed stake & stone beside it, drove iron pipe; see wit.; meas. N.1326' to 1/8 post (stone) & cont. 1326' to 1/4 post (stone); meas. W. 1343' to 1/8 post & con. 1343' to 1/4 post (stone). Angle N. to W. 89°10'; meas. S. to 1/8 post 1328' & cont. 1328' to 1/4 post. Used in many surveys 1923 to 1956. 1956 WQ Smith CS, Used in many surveys 1956 to 1970. 8/4/71 survey rec. L.1 p.68; Rec. Cert. L.1 p.18. 10/3/1972 WQ Smith CS & D. Middleton RLS B. Description of corner evidence found and/or method applied in restoring or reestablishing corner: (Cont. on back)

K-3 Corner common to Sections 1, 2, 11, & 12 T3S-R14W Paw Paw Twp.


On October 15, 1993, found 1/2" iron rod over very old 1" iron pipe with old mon box over, approx. 1' deep, 4' W. of C/L road North & South, & 3' S. of C/L road to West, and in line with C/L of road to East. Removed 1/2" iron rod & old 1" iron pipe. Set Harrison marker & new mon box over old mon box.

THIS GOVERNMENT MONUMENT WAS RESTORED WITH APPROVAL OF THE VAN BUREN COUNTY REMONUMENTATION PEER GROUP OF SURVEYORS, AND IS ACCEPTED AS A CAREFUL AND FAITHFUL PERPETUATION OF THE POSITION OF THE ORIGINAL CORNER. THE APPROVAL MEETING WAS HELD ON SEPTEMBER 29, 1993.

C. Description of monument for corner and accessories established to perpetuate locating the position of the corner:

K-3 HARRISON MARKER IN MONUMENT BOX

- S.65°E. 39.55' Nail in North face pole.
N.75°E. 52.95' PK nail in South face 12" dia. Pine.
N.20°E. 72.25' PK nail in West face 11" Maple.
S.45°W. 102.90' PK nail in SE face 10" Oak.

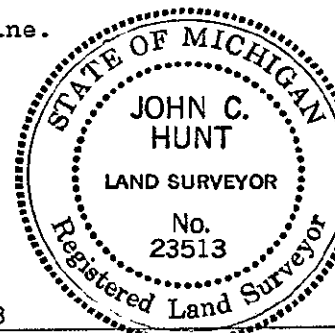

Signed by John C. Hunt, P.S. Date Oct. 16, 1993
Surveyor's Michigan License No. 23513

*LIBER 4 PAGE 53*

(Continued from front)

survey recorded L.3 p.173. 6/20/1972 survey recorded L.2 p.103. 6/22/1973 survey recorded L.3 p.249. 4/3/1974 survey recorded L.5 p.64.

7/11/1974 A. McMachen RLS, survey recorded L.5 p.214. 4/27/1975 survey recorded L.5 p.302.

3/15/1976 WQ Smith CS, survey recorded L.6 p.89, Gove.

10/28/1976 DR Gilchrist CS, Gove, survey recorded L.6 p.249.

4/26/1979 D. Pitts RLS, survey recorded L.8 p.92. 3/27/1979 survey recorded L.8 p.62.

8/20/1980 DR Gilchrist CS, survey recorded L.8 p.386. 6/21/1984 Survey. 4/27/1988 Survey & witnesses. 8/23/1988 Survey.