

1993 VAN BUREN COUNTY REMONUMENTATION PROGRAM

LAND CORNER RECORDATION CERTIFICATE Nov 19 1 49 PM '93
Filing Requirement of Act 74, Mich. P.A. 1970

COMMISSION

For corners in

Van Buren

Located In:

Corner Code #

W $\frac{1}{2}$ Post Sec. 12 K-4 Paw Paw Twp.

- 1. Public Land Survey Sec. 12 T 3 S. R 14 W. K-4
 T _____ R _____
 T _____ R _____
 T _____ R _____
- 2. Property Controlling S _____ T _____ R _____
 in Section S _____ T _____ R _____
- 3. Miscellaneous S _____ T _____ R _____
 Property in Sec. S _____ T _____ R _____

Mark A. Smith
VAN BUREN CO
REGISTER OF DEEDS

Register of Deeds Stamp & File Number

- 4. Lot No. _____, Recorded Plat _____
- 5. Private Claims _____

	A	B	C	D	E	F	G	H	I	J	K	L	M
2	6	5	4	3	2	1							
3													
4	7	8	9	10	11	12							
5													
6	18	17	16	15	14	13							
7													
8	19	20	21	22	23	24							
9													
10	30	29	28	27	26	25							
11													
12	31	32	33	34	35	36							
13													

I, John C. Hunt, P.S., in a field survey on Nov. 8, 19 93, do hereby certify that under requirements of P.A. 74, Michigan P.A. of 1970, the corner points mentioned in lines 1 and 2 above were in conformance with regulations and rules therefore as required in the current manual of survey instructions of the United States Department of the Interior, Bureau of Land Management or by a decree of a Court of Law and/or that the corner points mentioned in lines 3, 4 and 5 above were in conformance with the rules of the Michigan Board of Land Surveyors or by a Decree of a Court of Law; established, re-established, monumented, re-monumented, recovered, found as expressed below:

NOTE: Not more than 4 corners, all in the same town and range, may be recorded on this certificate.


A. Description of original monument and accessories and/or subsequent restoration: K-4
5/1830 Wm. Brookfield DS, set $\frac{1}{4}$ post. Wit.: 12" Y. Oak N.81°15'W. 39 lks., 12" Burr Oak N.8°30'E. 44 lks. 5/1900 Geo. Mutchler CS, Bk. 1 p.28, stone & brick, put in iron pump handle & crockery & witnessed. 4/1914 WH Goss CS, Bk. 1 p.198, fd. stone & pump handle & witnessed. Meas. W. to W $\frac{1}{2}$ Post 5339.40'. 5/19/1923 TA Smith CS, Red Bk., fd. iron bar 6" down & witnessed. 12/11/1951 WQ Smith CS, tied corner to subdivisions: Guercio Add., Lakeview Add., Wartewig Add. & Miller Add. 7/22/1971 DR Gilchrist RLS rec. survey L.1 p.55. 9/22/1971 WQ Smith CS & D. Middleton RLS, rec. surveys in L.1 p.195, L.2 p.103, & L.5 p.73. 7/9/1976 A. McMachen RLS, rec. survey in L.7 p.83. 10/28/1976 DR Gilchrist CS (Gove) rec. survey in L.6 p.249. 3/2/1978 A. McMachen, RLS filed Rec. Certificate in L.2 p.512. 6/16/1981 T. Woldring RLS (Gove) rec. survey in L.9 p.10.

B. Description of corner evidence found and/or method applied in restoring or reestablishing corner:
K-4 Corner common to Sections 11 & 12, T3S-R14W, Paw Paw Township.
Corner evidence found: Found "T" iron set in concrete in monument box in C/L N&S, & 2.5' N of C/L road E&W. Set Harrison Marker top in concrete over "T" iron in concrete in mon box. Note: Road has been recently re-paved. Mon box is at grade.

THIS GOVERNMENT MONUMENT WAS RESTORED WITH APPROVAL OF THE VAN BUREN COUNTY REMONUMENTATION PEER GROUP OF SURVEYORS AT A MEETING HELD ON SEPTEMBER 29, 1993, AND IS ACCEPTED AS A CAREFUL AND FAITHFUL PERPETUATION OF THE POSITION OF THE ORIGINAL CORNER.

C. Description of monument for corner and accessories established to perpetuate locating the position of the corner:
K-4 HARRISON MARKER IN CONCRETE IN MONUMENT BOX

- N.75°E. 36.77' Nail in North face pole.
- N.75°W. 46.95' PK nail in South face pole.
- S.15°E. 48.95' Nail in SW face pole.
- S.45°W. 56.83' NE corner 3' x 5.9' brick sign.

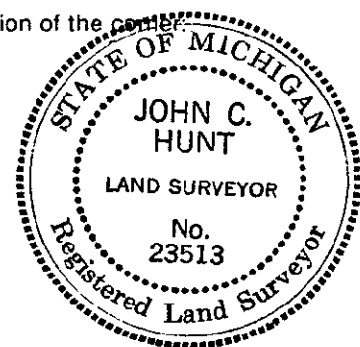

Signed by *John C. Hunt* Date November 18, 1993
Surveyor's Michigan License No. 23513