

JAN 17 1996 VAN BUREN COUNTY REMONUMENTATION PROGRAM

DEC 5 2 48 PM '94

COMMISSION LAND CORNER RECORDATION CERTIFICATE

For corners in VAN BUREN (County) Located in: Paw Paw Twp. Corner Code: #

Mark A. Smith VAN BUREN CO. DEPT. OF DEEDS

- 1. Public Land Survey Sec. 36 T 3 S, R 14 W. SE Corner T R M-13 A-13
2. Property Controlling in Section S T R
3. Miscellaneous Property in Sec. S T R

Register of Deeds Stamp & File Number

- 4. Lot No. Recorded Plat
5. Private Claims

Grid table with columns A-M and rows 2-13. Contains numbers 1-36.

I, John C. Hunt, PS, in a field survey on Oct. 19 & Nov. 22, 1994, do hereby certify that under requirements of P.A. 74, Michigan P.A. of 1970, the corner points mentioned in lines 1 and 2 above were in conformance with regulations and rules therefore as required in the current manual of survey instructions of the United States Department of the Interior, Bureau of Land Management or by a decree of a Court of Law and/or that the corner points mentioned in lines 3, 4 and 5 above were in conformance with the rules of the Michigan Board of Land Surveyors or by a Decree of a Court of Law; established, re-established, monumented, re-monumented, recovered, found as expressed below:

NOTE: Not more than 4 corners, all in the same town and range, may be recorded on this certificate.

A. Description of original monument and accessories and/or subsequent restoration: M-13 4/1827 GOV. Wm. Brookfield DS Set post at intersection cor. of temp. 6-mi. post & Range Line & wit.: 12" Blk. Ash S.11°W. 35 lks, 10" Maple N.82°E. 24 lks., & measured from surrounding twp. of Antwerp, Decatur, & Porter. 12/6/1900 G. Mutchler CS, see Book 1 p.58 & Red Book Sec. 6 Porter & Sec. 31 Antwerp shows iron & wit.: 11" Elm S.62°15'E. 62 1/2 lks or 83 1/2 lks & 3" Elm N.28°15'E. 39.25 lks. 7/28/1975 A. Howard RLS, rec. survey L.6 p.19, set pipes 21' N. & 33' N. & 10' E. Measured E. 1626.30' to 1/2 post, E. 2640' to each sec. cor., & N. 2628.5' to 1/2 post. 7/10/1981 J.C. Hunt RLS, survey shows corner; meas. N. 1313.73' to 1/8 post, E. 507' to iron Sec. 6 Porter Twp., W. 1089' to iron, S. 1723.75' to 1/8 post, W. 2646.79' to N 1/2 Post Sec. 1 Decatur Twp.; survey showing E. 1/2 of N. line of Sec. 6 Porter Twp. to be 2640'.

B. Description of corner evidence found and/or method applied in restoring or reestablishing corner: M-13 Corner common to Paw Paw, Antwerp, Decatur, & Porter Twp., S.E. corner Sec. 36 T3S-R14W, Paw Paw Twp. Corner evidence found: No corner found. Corner appears to have been obliterated by placement of new C.M.P. under road. Re-set from prior survey to West. Set Harrison Marker and mon box 4' S. of C/L road over old 36" C.M.P. in line with C/L of drainage ditch North & South. West 2646.79' nail at N 1/2 post of Sec. 1 Decatur Twp. 1644.79' West and 33' South 1/2" I.R. capped #23513.

THIS GOVERNMENT MONUMENT WAS RESTORED WITH APPROVAL OF THE VAN BUREN COUNTY REMONUMENTATION PEER GROUP OF SURVEYORS AT A MEETING HELD ON MAY 25, 1994, and is accepted as a careful and faithful PERPETUATION OF THE POSITION OF THE ORIGINAL CORNER.


Ratified by Peer Group in accordance with P.A. 345 of 1990 Van Buren County Surveyor

C. Description of monument for corner and accessories established to perpetuate locating the position of the corner: M-13 HARRISON MARKER IN MONUMENT BOX S.70°W. 68.96' Set PK nail & washer in N. face pole. S.43°E. 32.94' Set PK nail & washer in W. face pole. N.16°E. 31.97' Set PK nail & washer in W. face twin 7"-10" dia. tree. S.17°W. 24.60' South end of 5' dia. C.M.P.

Date S.P.S. 12/5/94

Signed by John C. Hunt, P.S. Surveyor's Michigan License No. 23513

Date Dec. 1, 1994

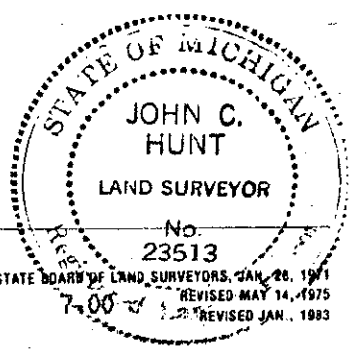

LIBER 4 PAGE 204