

VAN BUREN COUNTY REMONUMENTATION PROGRAM

NOV 15 1994

LAND CORNER RECORDATION CERTIFICATE
Filing Requirement of Act 74, Mich. P.A. 1970

AUG 12 11 21 AM '94

COMMISSION

For corners in

VAN BUREN
(County)

Located In:

Corner Code #

W 1/2 Post Sec. 10 Lawrence Twp.

1. Public Land Survey Sec. 10	T 3 S.	R 15 W.	G-4
	T	R	
	T	R	
	T	R	
2. Property Controlling in Section	S	T	R
	S	T	R
3. Miscellaneous Property in Sec.	S	T	R
	S	T	R

Mark A. Smith
VAN BUREN CO.
REGISTERED LAND SURVEYOR

Register of Deeds Stamp & File Number

4. Lot No. _____, Recorded Plat _____
5. Private Claims _____

A	B	C	D	E	F	G	H	I	J	K	L	M
2	6	5	4	3	2	1						
3												
4	7	8	9	10	11	12						
5												
6	18	17	16	15	14	13						
7												
8	19	20	21	22	23	24						
9												
10	30	29	28	27	26	25						
11												
12	31	32	33	34	35	36						
13												

I, John C. Hunt, P.S., in a field survey on Aug. 2, 19 94, do hereby certify that under requirements of P.A. 74, Michigan P.A. of 1970, the corner points mentioned in lines 1 and 2 above were in conformance with regulations and rules therefore as required in the current manual of survey instructions of the United States Department of the Interior, Bureau of Land Management or by a decree of a Court of Law and/or that the corner points mentioned in lines 3, 4 and 5 above were in conformance with the rules of the Michigan Board of Land Surveyors or by a Decree of a Court of Law; established, re-established, monumented, re-monumented, recovered, found as expressed below:

NOTE: Not more than 4 corners, all in the same town and range, may be recorded on this certificate.

A. Description of original monument and accessories and/or subsequent restoration:

G-4 5/11/1830 Wm. Brookfield D.S. He went N. bet. Sec. 9 & 10 a distance of 2540' & set 1/2 post; wit.: 40" Beech N48°15' 17.16'; 10" Beech S4°45'W 13.20'; continued N. to Paw Paw River 2919.84' & set post; wit.: 12" Beech N67°E 3.30', 24" Sugar Maple S10°E 5.28', cont. N. over river 3000.36' & set post on bank; wit.: 7" White Ash N14°W 13.20', 8" Elm N12°30'E 27.06'. Red Book Stone, wit.: Barn NW 39.0', Locust tree NE 42.5'. W.H. Goss, CS Note book shows stone & same wit. 4/8/1925 TA Smith CS Marker gone. Drove pipe from wit., Wit.: NE cor. barn S70°W 37.7', dbl. Locust tree W. 32.4' to C/L, SW cor. stone porch N50°E 76.1', near edge of sidewalk E. 34.0'. 2/22/1972 WQ Smith CS Rec. survey L.1 p.296 w/ wit. Rec. Cert. L.1 p.230 shows wit.: NE cor. barn S70°W 37.91'. 12/4/1973 Rec. survey shows cor. & dist. to C/L Bangor Rd. as 1031.16'. 5/27/1977 DR Gilchrist CS Rec. survey L.6 p.273 & L.1 p.230 showing cor. 4/22/1982 JC Hunt RLS Survey shows dist. from C/L Bangor Rd. S. to E 1/2 post as 1031.16'. 2/27/1985 JG Kamer RLS Survey shows cor. & 1/18/1986 Survey shows corner.

B. Description of corner evidence found and/or method applied in restoring or reestablishing corner:

G-4 Corner common to Sections 9 & 10, T3S-R15W, Lawrence Township, Village of Lawrence. Corner evidence found: 3/4" iron pipe in mon box 2.5' W. of C/L of pavement; Removed iron pipe & set Harrison Marker. *As per wit. rec. in L.1 p.230, rec. surveys.

THIS GOVERNMENT MONUMENT WAS RESTORED WITH APPROVAL OF THE VAN BUREN COUNTY REMONUMENTATION PEER GROUP OF SURVEYORS AT A MEETING HELD ON JULY 27, 1994, AND IS ACCEPTED AS A CAREFUL AND FAITHFUL REESTABLISHMENT OF THE POSITION OF THE ORIGINAL CORNER.


Ratified by Peer Group in accordance with P.A. 345 of 1990
Van Buren County Surveyor

Date 8/12/94 D. R. G.

C. Description of monument for corner and accessories established to perpetuate locating the position of the corner:

G-4 HARRISON MARKER inside raised mon box.

- N25°W 102.40' SE cor. F.O.P. Building.
- S80°W 38.30' NE cor. barn foundation.
- S15°E 55.00' C/L hydrant.
- N20°E 42.50' Spike in NW face pole.
- East 34.40' West edge of walk.
- N50°E 76.30' SW cor. stone porch.

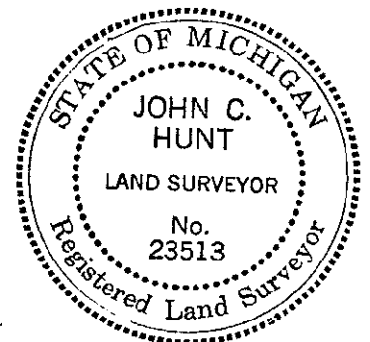

LIBER 4 PAGE 142

Signed by John C. Hunt, P.S. Date August 11, 1994

Surveyor's Michigan License No. 23513