

**SURVEY & REMONUMENTATION**

JAN 11 1999

SECTION

**VAN BUREN COUNTY REMONUMENTATION  
LAND CORNER RECORDATION CERTIFICATE**

Nov 4 4 29 PM '98

Filing Requirement of Act 74, Mich. P.A. 1970

*Mark A. Smith*  
VAN BUREN CO.  
REGISTER OF DEEDS

9-00  
1524 11/04 0101 108URVEY

For corners in

HARTFORD..... Township

..... VAN BUREN..... Located in: Corner Code #

- 1. Public Land Survey T...S R..16 W .....A-2.....  
T..... R..... W1/4 POST, SECTION 6
- 2. Property Controlling S..... T..... R.....  
in Section S..... T..... R.....
- 3. Miscellaneous S..... T..... R.....  
Property in Sec. S..... T..... R.....
- 4. Lot No. .... Recorded Plat .....
- 5. Private Claims.....

*LIBER 5 PAGE 110*

Register of Deeds Stamp & File Number

I, **George J. Mitchell**, in a filed survey on **8/26 thru 9/9/98**, do hereby certify that under requirements of P.A. 74, Michigan P.A. of 1970, the corner points mentioned in lines 1 and 2 above were in conformance with regulations and rules therefore as required in the current manual of survey instructions of the United States Department of the Interior, Bureau of Land Management or by decree of a Court of Law and/or that the corner points mentioned in lines 3, 4, and 5 above were in conformance with the rules of the Michigan Board of Land Surveyors or by decree of a Court of Law: established, re-established, monumented, re-monumented, recovered, found as expressed below:

NOTE: Not more than 4 corners, all in the same town & range, may be recorded on this certificate.

A. Description of original monument and accessories and/or subsequent restoration:

A-2

SEE SHEET 2 OF 2 FOR CORNER HISTORY

A	B	C	D	E	F	G	H	I	J	K	L
1	2	3	4	5	6	7	8	9	10	11	12
13	14	15	16	17	18	19	20	21	22	23	24
25	26	27	28	29	30	31	32	33	34	35	36
37	38	39	40	41	42	43	44	45	46	47	48
49	50	51	52	53	54	55	56	57	58	59	60

B. Description of corner evidence found and/or method applied in restoring or reestablishing corner:

A-2) CORNER NOT FOUND. SET CORNER ON TOWNSHIP LINE USING SINGLE PROPORTION METHOD. THIS POSITION NOT ESTABLISHED BY ORIGINAL GOVERNMENT SURVEY. THIS MONUMENT IS ACCEPTED AS A CAREFUL AND FAITHFUL DETERMINATION OF THE POSITION OF THE CORNER.

THIS CORNER WAS APPROVED BY THE VAN BUREN COUNTY SURVEYORS PEER GROUP ON SEPTEMBER 23, 1998

C. Description of monument for corner and accessories established to perpetuate locating the position of the corner:


A-2) WEST QUARTER POST OF SECTION 6, TOWN 3 SOUTH, RANGE 16 WEST.

SET 36" LONG HARRISON MARKER IN MONUMENT BOX.

WITNESS TAG & NAIL SET IN NW SIDE OF 8" APPLE	AZ.	220°	110.30 FEET
WITNESS TAG & NAIL SET IN NE SIDE OF 10" APPLE	AZ.	150°	99.75 FEET
WITNESS TAG & NAIL SET IN NORTH SIDE OF 12" APPLE	AZ.	120°	52.85 FEET
1" PIPE IN ROAD	AZ.	180°	26.80 FEET
BERRIEN COUNTY CORNER	AZ.	180°	43.40 FEET
CORNER A-2 TO A-1 MEASURED			2488.67 FEET
CORNER M-2 TO M-3 MEASURED			2622.91 FEET

Signed by *George J. Mitchell*  
Surveyor's Michigan License No. ....19618.....

Date *October 30, 1998*

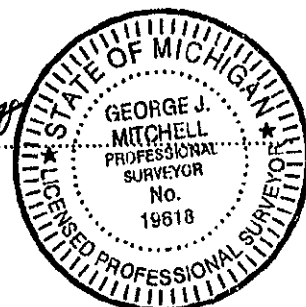

Validated by Peer Group in accordance with P.A. 345 of 1990  
Van Buren County Surveyor

Date *D. R. G. 11-4-98*

WEST QUARTER POST OF SECTION 6,  
TOWN 3 SOUTH, RANGE 16 WEST  
IN HARTFORD TOWNSHIP (A-2).

*LIBER 5 PAGE 111*

**CORNER NOT SET BY GOVERNMENT**

17.95 chs. (1184.70').

**12/19/1873 - A. J. Teed, C.S.**

Section 6

Book 4 - Page 141

There was nothing here, an old indian had a sprout about an inch in diam. but no  
defendence could put on it. I chained through from Southwest Corner to Northwest  
Corner and got at the distance that way.

Jog is 66 lks. (43.56') South.

**9/17/1903 - J. S. Haines, C.S.**

Section 6

Book 1 - Page 166 & Red Book.

Set bolt in skeim.

**Witnesses:**

12" Maple - S. 82 Deg. 45' E. - 48.4 lks. (31.95').

16" Elm - S. 30 Deg. W. - 92 lks. (60.72').

Distance South is 19.873 chs. (1311.62'), and continuing South 1311.62' to Section  
Corner for a total of 2623.24'.

Distance North is 19.879 chs. (1312.02'), and continuing North 17.83 chs. (1176.78')  
to Northwest Corner for a total of 2488.98'.

Distance East is 12.175 chs. (803.55') to Eighth Post, and continuing East 19.955 chs.  
(1317.03') to Center Quarter Post for a total of 2120.58'.

**6/19/1998 - G. Mitchell, P.S.**

Found no corner. Looked 27' m/l & 43' m/l North of Watervliet Township, Berrien County  
Corner.

**SURVEY &  
REMONUMENTATION**

**JAN 11 1999**

**SECTION**

*[Faint, illegible text]*