

**SURVEY &
REMONUMENTATION**

FILED

APR 25 1995

DEC 22 9 03 AM '94

COMMISSION
SE. Col. SEC. 31

LAND CORNER RECORDATION CERTIFICATE

Filing Requirement of Act 74, Mich. P.A. 1970

Mark A. Smith
VAN BUREN CO.
REGISTERED SURVEYOR

For corners in PORTER TWP.

<u>VAN BUREN</u> (County)	Located In:	Corner Code #
1. Public Land Survey	T <u>4</u> S R <u>13</u> W	<u>C-13</u>
	T _____ R _____	_____
	T _____ R _____	_____
	T _____ R _____	_____
2. Property Controlling in Section	S _____ T _____ R _____	_____
	S _____ T _____ R _____	_____
3. Miscellaneous Property in Sec.	S _____ T _____ R _____	_____
	S _____ T _____ R _____	_____

Register of Deeds Stamp & File Number

4. Lot No. _____, Recorded Plat _____
5. Private Claims _____

A	B	C	D	E	F	G	H	I	J	K	L	M
2	6	5	4	3	2	1						
3												
4	7	8	9	10	11	12						
5												
6	18	17	16	15	14	13						
7												
8	19	20	21	22	23	24						
9												
10	30	29	28	27	26	25						
11												
12	31	32	33	34	35	36						
13												

I, Allen H. McMachen a field survey on December 17, 19 94, do hereby certify that under requirements of P.A. 74, Michigan P.A. of 1970, the corner points mentioned in lines 1 and 2 above were in conformance with regulations and rules therefore as required in the current manual of survey instructions of the United States Department of the Interior, Bureau of Land Management or by a decree of a Court of Law and/or that the corner points mentioned in lines 3, 4 and 5 above were in conformance with the rules of the Michigan Board of Land Surveyors or by a Decree of a Court of Law; established, re-established, monumented, re-monumented, recovered, found as expressed below:

NOTE: Not more than 4 corners, all in the same town and range, may be recorded on this certificate.

A. Description of original monument and accessories and/or subsequent restoration:

1827 - William Brookfield, D.S.
Set Post
7" Tamarack N. 40° -15' W. 9 lks.
7" Tamarack N. 83° -15' E. 16 lks.

B. Description of corner evidence found and/or method applied in restoring or reestablishing corner:

Found ½" pipe 1' long excavated 3.5' below surface and found no additional evidence of corner. Found pipe was approved and authorized by the Van Buren County Remonumentation Peer Group.


Ratified by Peer Group in
accordance with P.A. 345 of 1990
Van Buren County Surveyor

Date 12/21/94 DRG

C. Description of monument for corner and accessories established to perpetuate locating the position of the corner:

Found ½" pipe is accepted as a careful and faithful reestablishment of the original corner. Removed pipe and placed Standard Van Buren County Section Corner monument and monument box over.
Accessories:

Nail & Tab in 6" Ash N. 2° W. 29.28'
Nail & Tab in 6" Ash SOUTH 49.85'
Nail & Tab in 14" Willow S. 40° E. 32.77'
Nail & Tab in 6" Tree S. 75° W. 22.13'

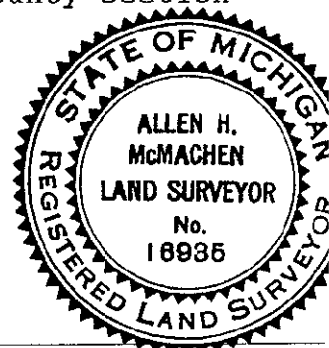

Signed by Allen H. McMachen Date 12/21/94
Surveyor's Michigan License No. 16935