

SURVEY & REMONUMENTATION

FILED

APR 25 1995

DEC 28 9 1 AM '94

S $\frac{1}{2}$ Sec. **6** COMMISSION

LAND CORNER RECORDATION CERTIFICATE
Filing Requirement of Act 74, Mich. P.A. 1970

For corners in PORTER TWP.

Mark A. Smith
VAN BUREN CO.
REGISTERED LAND SURVEYOR

VAN BUREN (County)	Located In:	Corner Code #
1. Public Land Survey	T <u>4</u> S R <u>13</u> W	<u>D-13</u>
	T _____ R _____	_____
	T _____ R _____	_____
	T _____ R _____	_____
2. Property Controlling in Section	S _____ T _____ R _____	_____
	S _____ T _____ R _____	_____
3. Miscellaneous Property in Sec.	S _____ T _____ R _____	_____
	S _____ T _____ R _____	_____

Register of Deeds Stamp & File Number

4. Lot No. _____, Recorded Plat _____
5. Private Claims _____

	A	B	C	D	E	F	G	H	I	J	K	L	M
2	6		5		4		3		2		1		
3													
4	7		8		9		10		11		12		
5													
6	18		17		16		15		14		13		
7													
8	19		20		21		22		23		24		
9													
10	30		29		28		27		26		25		
11													
12	31		32		33		34		35		36		
13													

I, Allen H. McMachen a field survey on December 22, 19 94, do hereby certify that under requirements of P.A. 74, Michigan P.A. of 1970, the corner points mentioned in lines 1 and 2 above were in conformance with regulations and rules therefore as required in the current manual of survey instructions of the United States Department of the Interior, Bureau of Land Management or by a decree of a Court of Law and/or that the corner points mentioned in lines 3, 4 and 5 above were in conformance with the rules of the Michigan Board of Land Surveyors or by a Decree of a Court of Law; established, re-established, monumented, re-monumented, recovered, found as expressed below:

NOTE: Not more than 4 corners, all in the same town and range, may be recorded on this certificate.

A. Description of original monument and accessories and/or subsequent restoration:

1827 - William Brookfield, D.S.

Set post, Wits: 12" Wh. Oak N. 87° -20' W. 51ks (3.3')
14" Wh. Oak N. 52° -30' E. 591ks (38.94')

1962 - W.Q. Smith, C.S.

Wits: Power Pole NORTH 20.9'
3" Maple S.W. 55.6'

1977 - T.J. Woldring


Found 3/4" Iron bar, Set R.R. Spike with "X" over it
Power Pole NORTH 20.93' to T. & W.
Phone Pole S. 70° E. 71.00' to T. & W. 6" Maple S. 60 W. 55.66'

B. Description of corner evidence found and/or method applied in restoring or reestablishing corner:

Found R.R. Spike with "X", Removed Spike and found 3/4" Pipe below, Cor. matches 2 remaining witnesses from 1962 W.Q. Smith Survey which also appear on 1977 Woldring Survey. 3/4" Pipe was approved and authorized by the Van Buren County Remonumentation Peer Group on June 1, 1994.

Ratified by Peer Group in
accordance with P.A. 345 of 1990
Van Buren County Surveyor

Date 12/28/94 D.R.G.

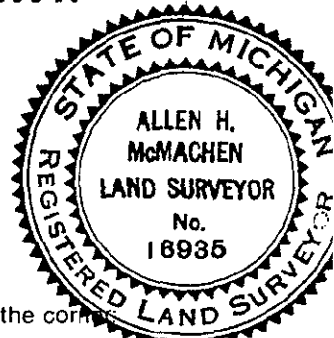

C. Description of monument for corner and accessories established to perpetuate locating the position of the corner:

Found 3/4" Pipe is accepted as a careful & faithful reestablishment of the original corner. Removed pipe and placed standard Van Buren County Section Cor. Monument and Mon. Box over, Accessories:

- Nail & Tab in cut off Utility Pole (previous power pole witness now being used for fence corner) NORTH 20.96'
- Nail & Tab in 18" Walnut N. 80° E. 99.33'
- Nail & Tab in 12" Maple (previous witness) S. 55° W. 55.11'
- Iron rod with IWM cap S. 20° E. 16.84'

Signed by Allen H. McMachen
Surveyor's Michigan License No. 16935

Date 12/27/94