

JAN 17 1996

DEC 22 9 52 AM '95

COMMISSION AND CORNER RECORDATION CERTIFICATE

Filing Requirement of Act 74, Mich. P.A. 1970

For corners in

Van Buren

(County)

Porter Twp.

Located In:

N.W. Cor., Sec. 4

Corner Code #

E-1

1. Public Land Survey

T 4 S R 13 W

T R

T R

T R

2. Property Controlling in Section

S T R

S T R

3. Miscellaneous Property in Sec.

S T R

S T R

Mark A. Smith  
VAN BUREN CO.  
REGISTER OF DEEDS

Register of Deeds Stamp & File Number

4. Lot No. , Recorded Plat

5. Private Claims

	A	B	C	D	E	F	G	H	I	J	K	L	M
2	6		5		4		3		2		1		
3													
4	7		8		9		10		11		12		
5													
6	18		17		16		15		14		13		
7													
8	19		20		21		22		23		24		
9													
10	30		29		28		27		26		25		
11													
12	31		32		33		34		35		36		
13													

I, James E. Boynton, in a field survey on October 2, 1995, do hereby certify that under requirements of P.A. 74, Michigan P.A. of 1970, the corner points mentioned in lines 1 and 2 above were in conformance with regulations and rules therefore as required in the current manual of survey instructions of the United States Department of the Interior, Bureau of Land Management or by a decree of a Court of Law and/or that the corner points mentioned in lines 3, 4 and 5 above were in conformance with the rules of the Michigan Board of Land Surveyors or by a Decree of a Court of Law; established, re-established, monumented, re-monumented, recovered, found as expressed below:

NOTE: Not more than 4 corners, all in the same town and range, may be recorded on this certificate.

A. Description of original monument and accessories and/or subsequent restoration:

1830, original corner established by E.H. Lytle, D.S.

1897, could not find corner - reset from Antwerp Corner - G. Muehler

1900, W.H. Goss, C.S. - corner gone

1972, L.C.R.C. set 1" pipe over 60d nail at jog distance from Antwerp corner.

1972, 1978 & 1995 surveys call for 1" pipe in mon. box

B. Description of corner evidence found and/or method applied in restoring or reestablishing corner:

Found pipe in mon box from above and accepted as best evidence of original corner.

Ratified by Peer Group in accordance with P.A. 345 of 1990 Van Buren County Surveyor

Date 7-26-95 D. R. A.

C. Description of monument for corner and accessories established to perpetuate locating the position of the corner:

Set standard marker over pipe as directed by The Peer Group on July 26, 1995.

S.W. corner garage N. 16° E. 121.86'

12" Oak N. 57° E. 102.18'

Oak S. 72° E. 68.75'


Street sign S. 60° W. 47.84'

Antwerp corner is West 42.16'

Signed by James E. Boynton

Date December 17, 1995

Surveyor's Michigan License No. 29239

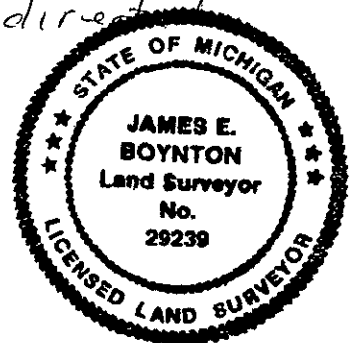

Like 4 pg. 345