

JAN 14 1998

VAN BUREN COUNTY REMONUMENTATION PROGRAM

DEC 18 12 06 PM '97

SECTION PORTER TOWNSHIP

LAND CORNER RECORDATION CERTIFICATE  
Filing Requirement of Act 74, Mich. P.A. 1970

For corners in Van Buren

Mark A. Smith  
VAN BUREN CO. PORTER TWP. MI.

7-00

1018 0101 105URVEY

(County)	Located In:	Corner Code #
1. Public Land Survey SW cor. Sec. 15	T 4 S. R 13 W.	G-7
	T R	
	T R	
	T R	
2. Property Controlling in Section	S T R	
	S T R	
3. Miscellaneous Property in Sec.	S T R	
	S T R	

Liber 5 Page 70

Register of Deeds Stamp & File Number

4. Lot No. \_\_\_\_\_, Recorded Plat \_\_\_\_\_  
5. Private Claims \_\_\_\_\_

	A	B	C	D	E	F	G	H	I	J	K	L	M
2	6	5	4	3	2	1							
3													
4	7	8	9	10	11	12							
5													
6	18	17	16	15	14	13							
7													
8	19	20	21	22	23	24							
9													
10	30	29	28	27	26	25							
11													
12	31	32	33	34	35	36							
13													

John C. Hunt, P.S. December 9 97

I, \_\_\_\_\_, in a field survey on \_\_\_\_\_, 19 \_\_\_\_\_, do hereby certify that under requirements of P.A. 74, Michigan P.A. of 1970, the corner points mentioned in lines 1 and 2 above were in conformance with regulations and rules therefore as required in the current manual of survey instructions of the United States Department of the Interior, Bureau of Land Management or by a decree of a Court of Law and/or that the corner points mentioned in lines 3, 4 and 5 above were in conformance with the rules of the Michigan Board of Land Surveyors or by a Decree of a Court of Law; established, re-established, monumented, re-monumented, recovered, found as expressed below:

NOTE: Not more than 4 corners, all in the same town and range, may be recorded on this certificate.

A. Description of original monument and accessories and/or subsequent restoration:

1/1830 Gov.: EH Lytle DS: Set post, Wit.: 14" w.oak N58°E 45 lks., 24" whitewood N59°30'W 33 lks. 3/1/1867 CD Lawton CS: Sec. 22, stone & survey of NW¼. 11/14/1968 D Gilchrist RLS: Sec. 15, fd. 1½" pipe. Fd. 1/8th post E.: p.stone on its side; occ. good. Lawton fd. stone in 2/28/1867. S. axle shaft over. 11/28/1972 WQ Smith CS: dist. W. is 2637'+-. 1/23/1973 DA Middleton RLS: Rec. Cert. L.2 p.85. Fd. 1½" pipe to surface paving patch, wit.: St. sign NE 37.56' to C/L; tack/washer N. root of 24" maple SE 42.89'; tack/washer S. side of RR tie NW 43.95'. 4/15/1976 WQ Smith RLS: Sec. 22 rec. sur. L.6 p.111. Fd. 1½" pipe to surface paving patch. Wit. ditto above. Dist. S 2654.18', dist. E 1330.8' to 1/8th po. & cont. E 1330.8' to ¼ po., total 2661.60'. 4/16/1986 JC Hunt RLS: Sec. 16 rec. sur. L.9 p.133. Dist. W 2637.50', dist. N 2650.24' to ¼ po. Fd. 1" pipe C/L-C/L rds. Wit. S50°E 45.30' set spike W face 24" dia. tree. N70°E 101.6' set spike N face pole. S50°W 76.3' set spike N root 24" tree. See rec. cert.L.3 p.107


B. Description of corner evidence found and/or method applied in restoring or reestablishing corner:

G-7 Corner common to sections 15, 16, 21, & 22, T4S-R13W, Porter Twp., Van Buren Co., MI. Dug for stone but did not find one. Found 1½" iron pipe in mon box in centerline of road North & South (28th St.) and 1' South of centerline of road East & West (C.R. 352). Removed pipe and set Harrison Marker in mon box.

THIS GOVERNMENT MONUMENT WAS RESTORED WITH APPROVAL OF THE VAN BUREN COUNTY REMONUMENTATION PEER GROUP OF SURVEYORS AT A MEETING HELD ON JUNE 11, 1997, AND IS ACCEPTED AS A CAREFUL AND FAITHFUL PERPETUATION OF THE POSITION OF THE ORIGINAL CORNER.

Ratified by Peer Group in accordance with P.A. 345 of 1990  
Van Buren County Surveyor

Date D. R. J. 12/18/97

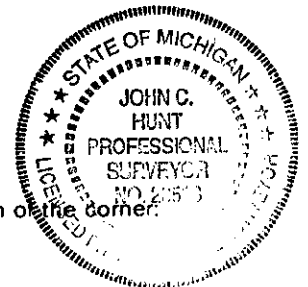

C. Description of monument for corner and accessories established to perpetuate locating the position of the corner:

G-7 Harrison Marker in mon box.  
S65°E 68.14' Set PK nail & washer in Northerly root of 36" Maple tree.  
N40°W 44.10' Found nail & washer in East face of RR tie leaning to North.  
N32°W 55.35' Set PK nail & washer in Southwest face of 6" diameter wood post to GTE cable box.  
S48°W 75.45' Set PK nail & washer in East base of 26" Maple tree.  
N22°E 106.70' Set PK nail & washer in West face utility pole.

Signed by John C. Hunt, P.S.

Date December 10, 1997

23513

Surveyor's Michigan License No. \_\_\_\_\_