

Nov 19 9 46 AM '98

LAND CORNER RECORDATION CERTIFICATE
Filing Requirement of Act 74, Mich. P.A. 1970

Mark A. Smith
VAN BUREN CO.
REGISTERED SURVEYOR

9.00

For corners in Porter Township

Van Buren (County)	Located in:	Corner Code #
1. Public Land Survey	T <u>4S</u> R <u>13W</u>	<u>L-7</u>
S 1/4 Post, Sec 13	T ___ R ___	___
	T ___ R ___	___
	T ___ R ___	___
2. Property Controlling in Section	S ___ T ___ R ___	___
	S ___ T ___ R ___	___
3. Miscellaneous Property in Sec.	S ___ T ___ R ___	___
	S ___ T ___ R ___	___

LIBER 5 PAGE 128

Register of Deeds Stamp & File Number

11/19 0101 10SURVEY

4. Lot No. _____, Recorded Plat _____
5. Private Claims _____

I, Donald R. Gilchrist in a field survey on Nov. 13, 1998 do hereby state that under requirements of P.A. 74, Michigan P.A. of 1970, the corner points mentioned in lines 1 and 2 above were in conformance with regulations and rules therefore as required in the current manual of survey instructions of the United States Department of the Interior, Bureau of Land Management or by a decree of a Court of Law and/or that the corner points mentioned in lines 3, 4 and 5 above were in conformance with the rules of the Michigan Board of Land Surveyors or by a Decree of a Court of Law; established, re-established, monumented, recovered, found as expressed below:

NOTE: Not more than 2 corners, all in the same town and range, may be recorded on this certificate.

	A	B	C	D	E	F	G	H	I	J	K	L	M
1													
2	6		5		4		3		2				1
3													
4	7		8		9		10		11				12
5													
6	18		17		16		15		14				13
7													
8	19		20		21		22		23				24
9													
10	30		29		28		27		26				25
11													
12	31		32		33		34		35				36
13													

A. Description of original monument and accessories and/or subsequent restoration:

1/1830 - GOVERNMENT - E.H. Lytle, D.S.
Corrected line between Sections 13 and 24, Set Section Quarter Post at 40.015 chs. (2640.99')
Witnesses:
6" Beech - N 33° W - 26 lks. (17.16').
12" Beech - S 16° W - 14 lks. (9.24').

(Continued on back of Certificate)

SURVEY &
REMONUMENTATION

JAN 11 1999

SECTION

B. Description of corner evidence found and/or method applied in restoring or reestablishing corner:

Measured from S 1/4 Post of 1/8 Post 1321.61' (Goss 1321.82') 1-1/4" bar to Center 1/4 (well point - Goss 1321.82) M = 1321.68' - Measured N to 1/8 Post (Goss well point - 1325.12') 1325.00'. Measured from NW Corner +- to County Line 5309.73' (Goss measured 5311.68'). Split distance 2654.86', dug, found stone down 2" small stones around distance S to 1/8 Post = 1324.55 (Goss = 1325.12').

Approved at the 8/26/98 Meeting of the Van Buren County Remonumentation Committee and is accepted as the best available evidence of the position of the original corner.


C. Description of monument for corner and accessories established to perpetuate locating the position of the corner:

Set Harrison Marker in Monument Box over stone.
Empty Monument Box 4.5' N and 2' E.
Centerline Road 4' N.
P.P. - N 16° W - 106.59' N/W E side.
P.P. - N 66° E - 191.09' N/W S side.
14" Elm - S 8° E - 155.84' N/W in W side.
Nail in NE Corner main part of building S 58° W - 130.65'

Ratified by Peer Group in
accordance with P.A. 345 of 1990
Van Buren County Surveyor

Date D. R. G. 11/19/98

Signed by Donald R. Gilchrist
Surveyor's Michigan License No. RLS 13583

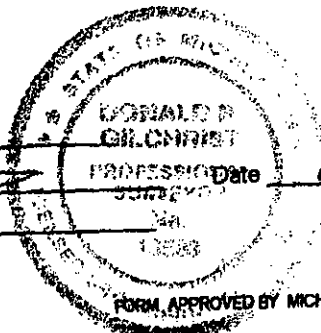

5/25/1905 - W.H. Goss, C.S.

Section 24

Book 1 - Page 188, Red Book & Goss Notes.

Found stones.

LIBER 5 PAGE 129

Witnesses:

30" Elm - S 83° 30' E - 4.32 lks. (2.85').

30" Walnut - S 47° 30' W - 56.25 lks. (37.13').

Northeast Corner School House - S 88° W - 212 lks. (139.92').

Distance West is 20.12 chs. (1327.92') and continuing 1327.92' to Northwest Corner for a total of 2655.84'.

Distance East is 20.12 chs. (1327.92') and continuing 1327.92' to Northeast Corner for a total of 2655.84'.

Distance South is 20.0775 chs. (1325.12') and continuing 1325.12' to Center Quarter Post for a total of 2650.24'.

10/20/1952 - W.Q. Smith, C.S.

Section 24

Drawing shows distance South of 2650.24' to Center Quarter Post.

SURVEY &
REMONUMENTATION

JAN 11 1999

SECTION