

**SURVEY & REMONUMENTATION**

JUN 29 1995

COMMISSION

**VAN BUREN COUNTY REMONUMENTATION PROGRAM**

**LAND CORNER RECORDATION CERTIFICATE**

Filing Requirement of Act 74, Mich. P.A. 1970

For corners in **DECATUR TWP.**

<u>VAN BUREN</u> (County)	Located In:	Corner Code #
1. Public Land Survey Sec. 18 NW Cor.	T <u>4</u> S. R <u>14</u> W. T _____ R _____ T _____ R _____ T _____ R _____	<u>A-5</u> _____ _____ _____
2. Property Controlling in Section	S _____ T _____ R _____ S _____ T _____ R _____	_____ _____
3. Miscellaneous Property in Sec.	S _____ T _____ R _____ S _____ T _____ R _____	_____ _____
4. Lot No. _____, Recorded Plat _____		
5. Private Claims _____		

FILED

JUN 13 4 20 PM '95

*Mark A. Smith*  
VAN BUREN CO.  
REGISTER OF DEEDS

Liberty Page 293  
Register of Deeds Stamp & File Number

I, John C. Hunt, P.S., in a field survey on March 14, 1995, do hereby certify that under requirements of P.A. 74, Michigan P.A. of 1970, the corner points mentioned in lines 1 and 2 above were in conformance with regulations and rules therofore as required in the current manual of survey instructions of the United States Department of the Interior, Bureau of Land Management or by a decree of a Court of Law and/or that the corner points mentioned in lines 3, 4 and 5 above were in conformance with the rules of the Michigan Board of Land Surveyors or by a Decree of a Court of Law, established, re-established, monumented, re-monumented, recovered, found as expressed below:

A	B	C	D	E	F	G	H	I	J	K	L	M
2	6	5	4	3	2	1						
3												
4	7	8	9	10	11	12						
5												
6	18	17	16	15	14	13						
7												
8	19	20	21	22	23	24						
9												
10	30	29	28	27	26	25						
11												
12	31	32	33	34	35	36						
13												

**NOTE: Not more than 4 corners, all in the same town and range, may be recorded on this certificate.**

**A. Description of original monument and accessories and/or subsequent restoration:**

A-5 1827 GLO, Wm. Brookfield DS: Ran W. bet. Sec. 7 & 18 a distance of 40 chs. to 1/4 sec. post. Intersected W. boundary at 70.74 chs. = 4668.84' (30.74 chs. = 2028.84') at point 182 lks. = 120.12' N. of post. Set post at intersection. Wit.: 9" Beech S.22°E. 16 lks. (10.56'), 9" Tamarack N.30°E. 31 lks. (20.46'). 5/1/1872 AJ Pierce CS: Shows jog at 185 lks. (122.10'), Sec. cor. OK, renewed good stake. Hamilton cor. good stake, wit. remain. Meas. E. 10.715 chs. (707.19') to 1/8 post & cont. E. 19.55 chs. (1290.30') to 1/4 post for total of 1997.49'. Meas. N. 39.93 chs. (2635.38') to 1/4 post. 10/28/1908 WH Goss CS: Cor. gone. Meas. for Hamilton cor., meas. E. 10.71 chs. (706.86'). 4/1960 WQ Smith CS: Drawing shows cor. & distance E. 2011.02' to 1/4 post & cont. E. 2632.03' to NE cor. of sec. Shows distance S. 1324.32' to 1/8 post & cont. S. 1324.32' to 1/4 post for a total of 5297.52'.

**B. Description of corner evidence found and/or method applied in restoring or reestablishing corner:**

A-5 Section corner common to Sections 7 & 18, T4S-R14W, Decatur Township. Found 1/2" iron rod in centerline of shallow drainage ditch North & South & in line with drainage ditch to West.

Set 1/2" Iron Rod S.88°11'15"E. 20.00' from above section corner for reference only.  
Witnesses for Reference Corner:

- North 2.81' Set PK nail & washer in East face 10" Wild Cherry tree.
- S.80°E. 29.35' Set PK nail & washer in South face of 24" Oak tree.
- S.65°E. 32.82' Set PK nail & washer in West face of 26" Maple clump.
- S.35°W. 38.28' Set PK nail & washer in East face of 11" dia. tree.

THIS GOVERNMENT MONUMENT WAS RESTORED WITH APPROVAL OF THE VAN BUREN COUNTY REMONUMENTATION PEER GROUP OF SURVEYORS AT A MEETING HELD FEBRUARY 15, 1995, AND IS ACCEPTED AS A CAREFUL AND FAITHFUL REESTABLISHMENT OF THE POSITION OF THE ORIGINAL CORNER.

**C. Description of monument for corner and accessories established to perpetuate locating the position of the corner:**

A-5 4' long Range Pole with cap #23513.

- West 9.43' Set PK nail & washer in North face of 7" dia. tree.
- S.15°W. 27.85' Set PK nail & washer in East face of 11" dia. tree.
- S.85°E. 20.17' Set PK nail & washer in North face of 15" Wild Cherry tree.
- N.25°E. 46.42' Set PK nail & washer in West face of 24" dia. tree.

Restified by Peer Group in accordance with P.A. 345 of 1990  
Van Buren County Surveyor

Date J. R. S. R.R.H.



Signed by John C. Hunt, ps.  
Surveyor's Michigan License No. 23513


Date June 7, 1995



3-14-95  
JOHN HINT  
P.S. #23513

E 1/4 POST SEC 12,  
T 45 R 15W.

SEC. 12, T 45-R 15W,  
HAMILTON TWP.

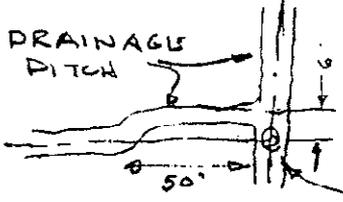

1/4 POST

SEC. 13, T 45-R 15W,  
HAMILTON TWP.

E 1/4 POST SEC 13,  
T 45-R 15W.

W 1/4 POST SEC. 7,  
T 45 R 14W.

SEC. 7, T 45 R 14W  
DECATUR TWP.

TOWN LINE

SEC. COR. COMMON TO SEC.  
7 & 18, T 45-R 14W.

PRIOR SURVEYS  
SHOWS FENCE  
NEAR LINE

SEC 18, T 45-R 14W  
DECATUR TWP.

W 1/4 POST SEC 18,  
T 45-R 14W.

