

**SURVEY &  
REMONUMENTATION**

APR 25 1995

FILED

**COMMISSION**

**LAND CORNER RECORDATION CERTIFICATE**

Filing Requirement of Act 74, Mich. P.A. 1970

NOV 22 8 44 AM '94

For corners in Decatur Township

Van Buren County

(County)

Located In:

Corner Code #

1. Public Land Survey	T	4S	R	14W	9A
	T		R	15W	
SW Corner Sec 19	T		R		
	T		R		
2. Property Controlling in Section	S		T		
	S		T		
3. Miscellaneous Property in Sec.	S		T		
	S		T		

*Mark A. Smith*  
VAN BUREN CO  
REGISTER OF DEEDS

Register of Deeds Stamp & File Number

4. Lot No. \_\_\_\_\_, Recorded Plat \_\_\_\_\_  
5. Private Claims \_\_\_\_\_

	A	B	C	D	E	F	G	H	I	J	K	L	N
2	6		5		4		3		2		1		
3													
4	7		8		9		10		11		12		
5													
6	18		17		16		15		14		13		
7													
8	19		20		21		22		23		24		
9													
10	30		29		28		27		26		25		
11													
12	31		32		33		34		35		36		
13													

I, Donald R. Gilchrist, in a field survey on October 13, 1994

do hereby certify that under requirements of P.A. 74, Michigan P.A. of 1970, the corner points mentioned in lines 1 and 2 above were in conformance with regulations and rules therefore as required in the current manual of survey instructions of the United States Department of the Interior, Bureau of Land Management or by a decree of a Court of Law and/or that the corner points mentioned in lines 3, 4 and 5 above were in conformance with the rules of the Michigan Board of Land Surveyors or by a Decree of a Court of Law; established, re-established, monumented, re-monumented, recovered, found as expressed below:

**NOTE:** Not more than 4 corners, all in the same town and range, may be recorded on this certificate.

A. Description of original monument and accessories and/or subsequent restoration:

3/1827. - Government - William Brookfield, DS, W on Section Line between Sections 19 & 30 a distance of 9.00 chs (594.0') to a Lake and set Post on East margin of swamp - 26.00 chs over Lake to W margin where a 6" Tamarack was used as Post - 31.00 chs left Swamp - 40.00 chs set Quarter Section Post. Witnesses: 6" B.Oak - N 21° W 38 lks (25.08'); 18" White Oak - S 14°30' E 79 lks (52.14'). Continuing West on Section Line at pt 70.45 chs (4649.70') and intersected W boundary at point 60 lks (39.60') North of Section Corner Post.

Continued on Back of Certificate

B. Description of corner evidence found and/or method applied in restoring or reestablishing corner:

Fd PK in paving - dug found 1/2" iron with stone beside - dug 3' found 3/4" pipe.  
Set slimline Harrison Marker in Monument Box over 3/4" pipe.

Approved at the 6/24/94 Van Buren County Peer Group Meeting and is accepted as a careful and faithful perpetuation of the position of the Original Government Corner.


Ratified by Peer Group in accordance with P.A. 345 of 1990  
Van Buren County Surveyor

Date D. R. G. 11/21/94

C. Description of monument for corner and accessories established to perpetuate locating the position of the corner:

Harrison Marker in Monument Box over 3/4" pipe.  
P.Pole - N 45° W - 17.73' PK/W in E side  
P.Pole - S 10° W - 77.87' PK/W in E side  
P.Pole - S 45° W - 130.78' PK/W in N side  
CL M-51 South on LI - 14'  
Jog - South - 39.97'

*Liber 4 page 196*

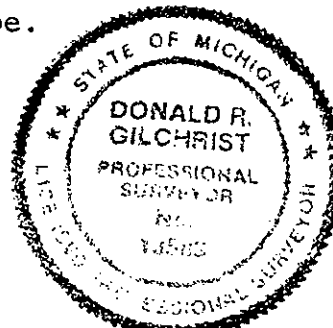

Signed by Donald R. Gilchrist

Date 11/14/94

Surveyor's Michigan License No. Donald R. Gilchrist, RLS #13583

A.

Witnesses:

- 10" Y. Oak - S 65 Deg 30' E - 64 lks (42.24').
- 12" B. Oak - N 24 Deg 45' E - 81 lks (53.46').

6/27/1873 - A. J. Teed, C.S.

Book 4 - Page 127 (Section 30).

Northeast Corner and both Meander Posts OK.

Northwest Corner Stake is standing.

Measured West from Quarter Post 14.40 chs (950.40') to Southeasterly Right of Way of Michigan Central Railroad.

4/8/1888 - A. A. Fosdick, C.S.

Found Stake (Section 30).

Measured West from Northeast Corner 39.90 chs (2633.40') to Quarter Post, and continued West 19.95 chs (1316.17') to Eighth Post, and continued West 10.42 chs (687.72'). Government = 10.45 chs (689.70') - Government Jog = 60 lks (39.60') South to Hamilton Corner.

4/27/1926 - T. A. Smith, C.S.

Witnesses:

Corner 39.6' North of Hamilton Corner.

Near Edge of Pavement - S 30 Deg E - 4.5'.

Near Grapevine - N 15 Deg E - 41.1'.

11/1946 - Survey showing Corner.

7/5/1951 - Michigan Department of Transportation.

Plans show Hamilton Corner as a 1.25" Gas Pipe, with Witnesses.

4/27/1961 - W. Q. Smith, C.S.

Survey shows Corner and an Iron 332.08' South of Hamilton Corner.

6/12/1961 - Survey shows Corner and a distance of 500.94' to Northwesterly Right of Way of Railroad.

9/16/1971 - Survey shows the same as above and witnesses. (Liber 1 - Page 161).

9/29/1971 - Survey shows the same as above and witnesses.

9/22/1971 - Recordation Certificate (Liber 1 Page 188).

8/27/1974 - Survey shows Corner.

Measured North 1264.02' to 1/2" Iron, and continued 823.66' to Plat Monument.

Measured Northeast along Center Line of M-51 Highway 753.87', and continued 625.96', and continued 1217.40'.

9/8/1978 - Allen McMachen, R.L.S.

Recorded Survey (Liber 7 - Page 73).

9/22/1978 - Terry Woldering, R.L.S.

Recorded Survey (Liber 7 - Page 198).

5/1993 - D. R. Gilchrist, C.S.

Used Hamilton Corner.

*Liber 4 page 197*