

DEC 28 1999

LAND CORNER RECORDATION CERTIFICATE
Filing Requirement of Act 74, Mich. P.A. 1970

SECTION
FILED

For corners in DECATUR
VAN BUREN

| (County) | Located In: | Corner Code # |
|---|--------------------------|---------------|
| 1. Public Land Survey S½ Post Sec. 6 | T <u>4S</u> R <u>14W</u> | <u>B-3</u> |
| | T _____ R _____ | _____ |
| | T _____ R _____ | _____ |
| | T _____ R _____ | _____ |
| 2. Property Controlling in Section | S _____ T _____ R _____ | _____ |
| | S _____ T _____ R _____ | _____ |
| 3. Miscellaneous Property in Sec. | S _____ T _____ R _____ | _____ |
| | S _____ T _____ R _____ | _____ |

APR 9 2 28 PM '99

Mark A. Smith
VAN BUREN COUNTY
REGISTER OF DEEDS

Register of Deeds Stamp & File Number

- 4. Lot No. _____, Recorded Plat _____
- 5. Private Claims _____

| | | | | | | | | | | | | | |
|----|----|---|----|---|----|---|----|---|----|---|----|---|---|
| | A | B | C | D | E | F | G | H | I | J | K | L | N |
| 2 | 8 | | 5 | | 4 | | 3 | | 2 | | 1 | | |
| 3 | | | | | | | | | | | | | |
| 4 | 7 | | 8 | | 9 | | 10 | | 11 | | 12 | | |
| 5 | | | | | | | | | | | | | |
| 6 | 16 | | 17 | | 16 | | 15 | | 14 | | 13 | | |
| 7 | | | | | | | | | | | | | |
| 8 | 19 | | 20 | | 21 | | 22 | | 23 | | 24 | | |
| 9 | | | | | | | | | | | | | |
| 10 | 30 | | 29 | | 28 | | 27 | | 26 | | 25 | | |
| 11 | | | | | | | | | | | | | |
| 12 | 31 | | 32 | | 33 | | 34 | | 35 | | 36 | | |
| 13 | | | | | | | | | | | | | |

John C. Hunt, P.S. April 1, 99

I, _____, in a field survey on _____, 19 _____, do hereby certify that under requirements of P.A. 74, Michigan P.A. of 1970, the corner points mentioned in lines 1 and 2 above were in conformance with regulations and rules therefore as required in the current manual of survey instructions of the United States Department of the Interior, Bureau of Land Management or by a decree of a Court of Law and/or that the corner points mentioned in lines 3, 4 and 5 above were in conformance with the rules of the Michigan Board of Land Surveyors or by a Decree of a Court of Law; established, re-established, monumented, re-monumented, recovered, found as expressed below:

NOTE: Not more than 4 corners, all in the same town and range, may be recorded on this certificate.

A. Description of original monument and accessories and/or subsequent restoration:

(B-3) 1/1830 Gov.: EH Lytle DS; ran W. bet. sec. 6 & 7 40 chs. (2640.00') & set sec. cor. on 24" sugar maple. Intersected W. boundary 180 lks (118.80') N. of post with distance of 30.57 chs (2017.62'). 5/3/1872 AJ Pierce CS; Sec. 7; bk. 4 p.99 & red book. Long white stone, preset, seems OK, wit. gone. Distance E. 19.96 chs (1317.36') & cont. 1317.36' to NE cor. for total of 2634.72'. 8/12/1873 AJ Teed CS; Sec. 6, Bk. 4 p.37 & red book, stone. Dist. E. is 39.96 chs (2637.36'). Distance N. is 39.75 chs (2623.50'). 1900 +/- WH Goss CS; Sec. 7, notes stone. Distance E. is 19.96 chs (1317.36'). 4/28/1998 JC Hunt PS; Sec. 6, sketch shows corner.

B. Description of corner evidence found and/or method applied in restoring or reestablishing corner:

(B-3) South quarter post of fractional Sec. 6, T4S-R14W, (quarter post common to Sections 6 & 7), Decatur Township, Van Buren County, Michigan.

Found 1/2" iron rod 0.5' South of South edge of pavement in line with brush row to North and in line with chain link fence to South. Removed iron & set Harrison Marker and mon box. (Note: Field notes from Southwest Survey & Eng. Co., Inc., shows distance measured to East of 2637.50' and distance measured to the West of 2078.90'; and also shows corner on straight line between corners East and West. Measurements taken in 1982.)


THIS GOVERNMENT CORNER WAS RESTORED WITH APPROVAL OF THE VAN BUREN COUNTY REMONUMENTATION PEER GROUP OF SURVEYORS AT A MEETING HELD ON MARCH 31, 1999, AND IS ACCEPTED AS THE BEST AVAILABLE EVIDENCE OF THE POSITION OF THE ORIGINAL CORNER.

C. Description of monument for corner and accessories established to perpetuate locating the position of the corner:

(B-3) HARRISON MARKER IN MONUMENT BOX

South 13.20' North face of steel rail set in concrete.
S15°W 37.56' Set mag nail in West face of pole.
N12°W 40.33' Set mag nail in Easterly root of 11" Maple.
N22°W 36.34' Set mag nail in Westerly root of 11" Maple.
S36°E 67.60' Northwest corner of house.

Notified by Peer Group in accordance with P.A. 345 of 1998
Van Buren County Surveyor
Date D.R.A. 4/9/99

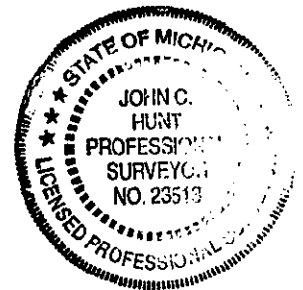

Signed by John C. Hunt, P.S. Date April 1, 1999
Surveyor's Michigan License No. 23513