

# SURVEY & REMONUMENTATION

APR 25 1995

COMMISSION

## VAN BUREN COUNTY REMONUMENTATION PROGRAM LAND CORNER RECORDATION CERTIFICATE Filing Requirement of Act 74, Mich. P.A. 1970

FILED

Dec 28 9 58 AM '94

For corners in Decatur Twp.

VAN BUREN (County)	Located In:	Corner Code #
1. Public Land Survey N $\frac{1}{4}$ Post Sec. 18	T 4 S. R 14 W.	B-5
	T _____ R _____	_____
	T _____ R _____	_____
	T _____ R _____	_____
2. Property Controlling in Section	S _____ T _____ R _____	_____
	S _____ T _____ R _____	_____
3. Miscellaneous Property in Sec.	S _____ T _____ R _____	_____
	S _____ T _____ R _____	_____

*Mark A. Smith*  
VAN BUREN CO.  
REGISTERED SURVEYOR

Register of Deeds Stamp & File Number

4. Lot No. \_\_\_\_\_, Recorded Plat \_\_\_\_\_  
5. Private Claims \_\_\_\_\_

I, John C. Hunt, P.S., in a field survey on Dec. 26, 19 94, do hereby certify that under requirements of P.A. 74, Michigan P.A. of 1970, the corner points mentioned in lines 1 and 2 above were in conformance with regulations and rules therefore as required in the current manual of survey instructions of the United States Department of the Interior, Bureau of Land Management or by a decree of a Court of Law and/or that the corner points mentioned in lines 3, 4 and 5 above were in conformance with the rules of the Michigan Board of Land Surveyors or by a Decree of a Court of Law; established, re-established, monumented, re-monumented, recovered, found as expressed below:

**NOTE: Not more than 4 corners, all in the same town and range, may be recorded on this certificate.**

	A	B	C	D	E	F	G	H	I	J	K	L	M
2	6	5	4	3	2	1							
3													
4	7	8	9	10	11	12							
5													
6	18	17	16	15	14	13							
7													
8	19	20	21	22	23	24							
9													
10	30	29	28	27	26	25							
11													
12	31	32	33	34	35	36							
13													

A. Description of original monument and accessories and/or subsequent restoration:  
B-5 1/16/1830 GOV.: EH Lytle DS, ran W. 40 chs, set  $\frac{1}{4}$  post; Wit.: 14" W. Oak N41°30'W 11 lks, 9" Beech S15°W 36 lks. 5/1/1872 AJ Pierce CS: Bk. 4 p.98-99, fd. old  $\frac{1}{4}$  post; fd. stump of 1 wit. remaining & roots of other 1 agreed; dug & fd. good evidence of old stake; set sassafras stake. 7/14/1949 TA Smith CS, notes & drawing show corner; meas. N. 548.8' to C/L road. 4/1960 Notes & drawing; distance from NE cor. to N $\frac{1}{4}$  post is 2632.03', cont. W. 2011.02' to NW cor. of section. 4/23/1969 & 1/30/1974 WQ Smith CS: Computation sheet shows N $\frac{1}{4}$  post of Sec. 18 as lg. dbl. Ash & fence, dist. E. 2631.41' to NE cor., dist. S. 2633.44' to C $\frac{1}{4}$  post (drawing shows 2633.04' to C $\frac{1}{4}$  post of Sec. 18). 6/16/1971 Rec. survey L.1 p.163-164, shows dist. N. to C/L road 548.80', Wit.: 4'+ high stump, 8" Hickory 8' +- E, dbl. 4" & 8" Hickory NW 3.2'+-. 6/14/1971: DA Middleton RLS, Rec. Cert. L.1 p.82. 10/22/1974: WQ Smith RLS: rec. survey L.6 p.93-94 same witnesses. 8/8/1978

B. Description of corner evidence found and/or method applied in restoring or reestablishing corner: rec. survey L.7 p.176-17  
B-5 North Quarter Post Sec. 18. Quarter Post common to sections 18 & 7 Decatur Twp.  
Corner evidence found: No corner found. Re-set from NE corner of section & 1/8 corner to North. Set Harrison Marker & Survey Witness Post on Northerly side. Corner is in line with down woven wire fence E. & W. and in remains of old stump. Found old flagging in ground by corner. S89°53'44"E 2631.41'  $\frac{1}{2}$ " iron rod for NE corner Sec. 18-4-14. N00°59'52"W 1323.70'  $\frac{1}{2}$ " iron rod #23513 for 1/8 corner. N00°59'52"W 548.80' Set PK nail 1.0' SWly exist. C/L pavement. S89°51'35"E 1837.53' fd.  $\frac{1}{2}$ " iron rod 1.15' S. of section line. 666.90' Nly of S. line section & 32.95' Ely fd.  $\frac{1}{2}$ " iron rod.


THIS GOVERNMENT MONUMENT WAS RESTORED WITH APPROVAL OF THE VAN BUREN COUNTY REMONUMENTATION PEER GROUP OF SURVEYORS AT A MEETING HELD ON APRIL 13, 1994, AND IS ACCEPTED AS A CAREFUL AND FAITHFUL REESTABLISHMENT OF THE POSITION OF THE ORIGINAL CORNER.

C. Description of monument for corner and accessories established to perpetuate locating the position of the corner:

B-5 HARRISON MARKER w/ Survey Witness Post on Northerly side.  
N.50°W. 3.22' Set PK nail & washer in S. root of twin 6"-12" Hickory.  
N.70°E. 8.00' Set PK nail & washer in S. face of 10" Hickory.  
S.60°E. 14.53' Set PK nail & washer in S. face 15" Oak.  
N.86°W. 23.44' Set PK nail & washer in S. face 15" Oak.

Ratified by Peer Group in accordance with P.A. 345 of 1990  
Van Buren County Surveyor

Date 12/28/94 *J. R. A.*

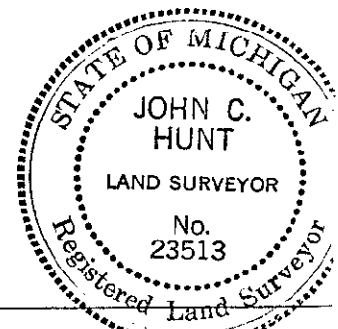

Signed by John C. Hunt, P.S. Date Dec. 27, 1994

Surveyor's Michigan License No. 23513

*Liber 4 Page 255*