

VAN BUREN COUNTY REMONUMENTATION PROGRAM

SURVEY &
RECORDATION

LAND CORNER RECORDATION CERTIFICATE
Filing Requirement of Act 74, Mich. P.A. 1970

DEC 28 1999

For corners in DECATUR

Van Buren (County)	Located In:	Corner Code #
1. Public Land Survey W $\frac{1}{4}$ Post Sec. 8	T 4S R 14W	C-4
	T R	
	T R	
	T R	
2. Property Controlling in Section	S T R	
	S T R	
3. Miscellaneous Property in Sec.	S T R	
	S T R	

SECTION
FILED

APR 9 2 28 PM '99

Mark A. Smith
VAN BUREN COUNTY
REGISTER OF DEEDS

Register of Deeds Stamp & File Number

- 4. Lot No. _____, Recorded Plat _____
- 5. Private Claims _____

John C. Hunt, P.S. March 27 1999
I, _____, in a field survey on _____, 19____, do hereby certify that under requirements of P.A. 74, Michigan P.A. of 1970, the corner points mentioned in lines 1 and 2 above were in conformance with regulations and rules therefore as required in the current manual of survey instructions of the United States Department of the Interior, Bureau of Land Management or by a decree of a Court of Law and/or that the corner points mentioned in lines 3, 4 and 5 above were in conformance with the rules of the Michigan Board of Land Surveyors or by a Decree of a Court of Law; established, re-established, monumented, re-monumented, recovered, found as expressed below:

A	B	C	D	E	F	G	H	I	J	K	L	M
2	6	5	4	3	2	1						
3												
4	7	8	9	10	11	12						
5												
6	18	17	16	15	14	13						
7												
8	19	20	21	22	23	24						
9												
10	30	29	28	27	26	25						
11												
12	31	32	33	34	35	36						
13												

NOTE: Not more than 4 corners, all in the same town and range, may be recorded on this certificate.

A. Description of original monument and accessories and/or subsequent restoration:

1/1830 Government: Wm. Brookfield, DS, ran North between sec. 7 & 8 40 chs. (2640') & set quarter section post. 5/3/1872: A.J. Pierce, CS; Sec. 7 Book 4, p.99, Quarter post established 2 years ago--witnesses remain--ran quarter lines--set the center quarter post. 7/13/1949: T.A. Smith, CS; Sec. 7. Field notes show corner & distance West of 1328.00' to railroad iron. 7/15/1952: W.Q. Smith, CS; Sec. 7. Field note drawing shows ditch running West on quarter line. 2/25/1966, Red Book. Set iron bar. Witnesses: 8" Cherry NW 33.6'; Fence corner East 23.6'. Field notes show 60p spike. Set corner 2656.00' S. of NW corner & 886.66' East of old pipe. Distance N. is 1328.00' to centerline of ditch, & continuing 1328.00' to section corner (pipe) for a total of 2656.00'. 1970 +/-: Found 3/4" pipe set by W.Q. Smith in 1966 & witnesses.

B. Description of corner evidence found and/or method applied in restoring or reestablishing corner:

W $\frac{1}{4}$ Post Sec. 8 (C-4), quarter post common to Sections 8 & 7, T4S-R14W, Decatur Twp., Van Buren Co., Michigan:

Found 3/4" iron bar 1' below surface in line with drainage ditch to West & in line with fence to East; 19' West of centerline of ditch to the N. & S. Measured South 2634.78' to SW corner of said Section 8.

Removed iron bar & set Harrison Marker & Witness Post.


THIS GOVERNMENT CORNER WAS RESTORED WITH APPROVAL OF THE VAN BUREN COUNTY REMONUMENTATION PEER GROUP OF SURVEYORS AT A MEETING HELD ON JANUARY 27, 1999, AND IS ACCEPTED AS THE BEST AVAILABLE EVIDENCE OF THE POSITION OF THE ORIGINAL CORNER.

C. Description of monument for corner and accessories established to perpetuate locating the position of the corner:

C-4 Harrison Marker & Witness Post:

- N73°W 33.54' Set mag nail & washer in S. face of 14" dia. tree.
- S78°W 18.72' Set mag nail & washer in N. face of 6" dia. tree.
- N53°W 36.08' Set mag nail & washer in NE face of 9" dia. tree.
- N10°W 90.39' Set mag nail & washer in E. face of 8" dia. tree.

Ratified by Peer Group in accordance with P.A. 345 of 1998
Van Buren County Surveyor
Date D.R.A. 4/9/99

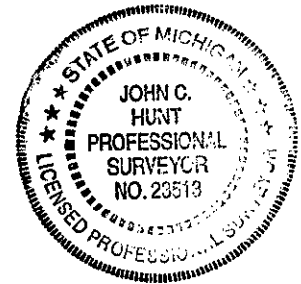

Signed by John C. Hunt, P.S. Date March 29, 1999
Surveyor's Michigan License No. 23513