SURVEY & REMONUMENTATION

JAN 14 1998

SECTION

FILED

DEC 23 8 59 AM '97

LAND CORNER RECORDATION CERTIFICATE
Filing Requirement of Act 74, Mich. P.A. 1970
VAN BUREN COUNTY REMONUMENTATION

Mark A. Smith
VAN BUREN CO.
REGISTER OF DEEDS

For corners in VAN BUREN (County)

	Located In:	Corner Code #
1. Public Land Survey S ½ COR SEC 32 DECATUR TWP.	T 4S R 14W	D13
	T___ R___	
	T___ R___	
	T___ R___	
2. Property Controlling	S___ T___ R___	
in Section	S___ T___ R___	
3. Miscellaneous	S___ T___ R___	
Property in Sec.	S___ T___ R___	

Liber 5 Page 84

Register of Deeds Stamp & File Number

7781 12/23 0101 10SURVEY

4. Lot No. _____ , Recorded Plat _____
5. Private Claims _____

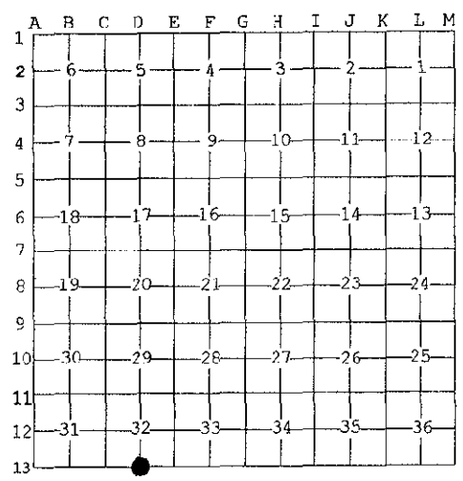

I, DALE L. KESLER, in a field survey on JULY 23, 1997 do hereby state that under requirements of P.A. 74, Michigan P.A. of 1970, the corner points mentioned in lines 1 and 2 above were in conformance with regulations and rules therefore as required in the current manual of survey instructions of the United States Department of the Interior, Bureau of Land Management or by a decree of a Court of Law and /or that the corner points mentioned in lines 3, 4 and 5 above were in conformance with the rules of the Michigan Board of Land Surveyors or by a Decree of a Court of Law; established, re-established, monumented, recovered, found as expressed below:

NOTE: Not more than 2 corners, all in the same town and range, may be recorded on this certificate.

A. Description of original monument and accessories and/or subsequent restoration:

*1827 WILLIAM BROOKFIELD. SET QUARTER SECTION POST. 10" BEECH N 23 1/4 DEGREES E 23 ½ LKS., 11" BEECH N 42 3/4 DEGREES W 21 LKS.
*APR. 15, 1901 GEORGE MUTCHLER. STONE., 6" SASSAFRAS S 72 DEGREES W .9 LKS., 8" ELM S 58 ½ DEGREES E .69 LKS.
*JUNE 30, 1971 SMITH & SMITH, INC., L.C.R.C. LIBER 1, PG 86, FOUND POINTED STONE 5' +/- EAST OF OLD FENCE SOUTH. WITNESSES: 18' +/- W OF RECENT FENCE RUNNING SOUTH, EAST & WEST FENCE 2.5' NORTH, RAILROAD TIE NORTH 2.5' TO CENTERLINE, 18" WHITEWOOD 13.0' EAST TO CENTERLINE.

B. Description of corner evidence found and/or method applied in restoring or reestablishing corner:

FOUND POINTED STONE. THE ACCESSORIES OF THE JUNE 30, 1971 SURVEY BY SMITH & SMITH VERIFY LOCATION OF CORNER. DISTANCES TO ADJACENT CORNERS WERE REASONABLE AND CONSISTENT. ACCEPTED FOUND POINTED STONE AS BEST EVIDENCE OF CORNER. THIS GOVERNMENT MONUMENT WAS RESTORED WITH APPROVAL OF THE VAN BUREN COUNTY REMONUMENTATION GROUP OF SURVEYORS AT A MEETING HELD OCTOBER 29, 1997 AND IS ACCEPTED AS THE BEST AVAILABLE EVIDENCE OF THE POSITION OF THE ORIGINAL CORNER.

C. Description of monument for corner and accessories established to perpetuate locating the position of the corner:

SET HARRISON MARKER IN PLACE OF STONE AND IS ACCEPTED AS THE BEST AVAILABLE EVIDENCE OF THE POSITION OF THE ORIGINAL CORNER.
RR TIE POST NORTH 2.50'
FENCE LINE E & W NORTH 2.50'
NAIL & TAG 27" OAK N 30 DEGREES E 31.45'
NAIL & TAG 10" MAPLE N 48 DEGREES E 22.45'
NAIL & TAG 12" MAPLE S 82 DEGREES W 13.74'
N 1/4 COR SEC. 5, T5S, R14W, EAST 1.98'

STATE OF MICHIGAN
DALE L. KESLER
LAND SURVEYOR
No. 38117
LICENSED LAND SURVEYOR

Signed by Dale L. Kesler

Date 12/22/97

Surveyor's Michigan License No. 38117

FORM APPROVED BY MICHIGAN STATE BOARD OF PROFESSIONAL SURVEYORS, JAN. 28, 1971
REVISED MAY 14, 1975
REVISED JAN., 1993
REVISED OCT., 1995

Ratified by Peer Group in accordance with P.A. 345 of 1990
Van Buren County Surveyor
Date D.R.S. 12/23/97