SURVEY & REMONUMENTATION

FILED

#97-18064
G6R4-14.tff

JAN 14 1998 VAN BUREN COUNTY REMONUMENTATION PROGRAM

DEC 18 12 06 PM '97

SECTION

Decatur Twp.

LAND CORNER RECORDATION CERTIFICATE

Filing Requirement of Act 74, Mich. P.A. 1970

Mark A. Smith
VAN BUREN CO. REGISTER OF DEEDS

For corners in Van Buren (County)

	Located In:	Corner Code #
1. Public Land Survey W¼ post Sec. 15	T 4S R 14W	G-6
	T ___ R ___	
	T ___ R ___	
	T ___ R ___	
2. Property Controlling	S ___ T ___ R ___	
in Section	S ___ T ___ R ___	
3. Miscellaneous	S ___ T ___ R ___	
Property in Sec.	S ___ T ___ R ___	

Liber 5 Page 74

Register of Deeds Stamp & File Number

7-00

12/18 0101 10SURVEY

7315

4. Lot No. _____, Recorded Plat _____
5. Private Claims _____

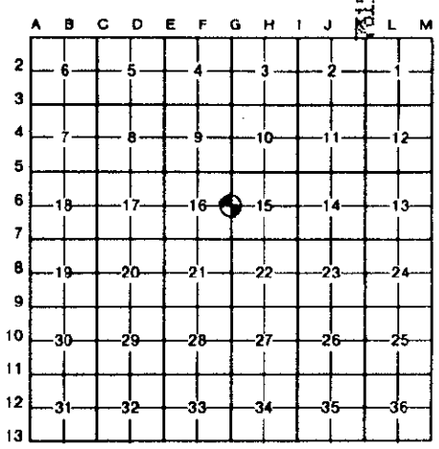

I, John C. Hunt, P.S., in a field survey on December 12, 19 97, do hereby certify that under requirements of P.A. 74, Michigan P.A. of 1970, the corner points mentioned in lines 1 and 2 above were in conformance with regulations and rules therefore as required in the current manual of survey instructions of the United States Department of the Interior, Bureau of Land Management or by a decree of a Court of Law and/or that the corner points mentioned in lines 3, 4 and 5 above were in conformance with the rules of the Michigan Board of Land Surveyors or by a Decree of a Court of Law; established, re-established, monumented, re-monumented, recovered, found as expressed below:

NOTE: Not more than 4 corners, all in the same town and range, may be recorded on this certificate.

A. Description of original monument and accessories and/or subsequent restoration:
1830 Gov.: W Brookfield DS: Ran N bet. sec. 15 & 16 40.00 chs. (2640') & set Post cor. Wit.: 12" w.oak S74°E 54 lks. (35.64'); 14" w.oak S88°W 60 lks. (39.60'). 11/14/1906 WH Goss CS: Sec. 15 Bk. 7 p.80, red bk. & notes. Corner gone--set stake & brick. Wit.: 8" w.oak N16°W 144 lks. (95.04'); 6" red cedar N61°E 135 lks. (89.10'). Dist. N 40.04 chs. (2642.64'); S 40.04 chs. (2642.64'); E 20.015 chs. (1320.99'), & cont. E 1320.99' to center ¼ post for total 2641.98'. 1/7/1992 JC Hunt PS: Rec. Cert. L.3 p.223. Fd. iron rd. Wit.: S3°W 35.41' SE edge RR tie fence post cor.; N73°W 70.78' nail 14" oak; N02°W 58.43' nail E. face pole; N40°E 140.95' nail SE face pole. 9/16/1993 DR Gilchrist CS: Sec. 15, survey shows cor. Dist. N 1319.49' to 1/8th post & cont. 1319.49' to NW cor. for total 2638.98'. Dist. E 1323.65' to 1/8th post & cont. E 1323.65' to center ¼ post for total of 2647.30'.

B. Description of corner evidence found and/or method applied in restoring or reestablishing corner:
G-6 Quarter Post common to sections 15 and 16, (West Quarter Post Sec. 15) T4S-R14W, Decatur Township, Van Buren Co., MI.: Found 1/2" iron rod 6.5' North of centerline of road. (No stake or bricks found, just 1/2" iron rod.) Removed iron rod and set Harrison marker in monument box.

THIS GOVERNMENT MONUMENT WAS RESTORED WITH APPROVAL OF THE VAN BUREN COUNTY REMONUMENTATION PEER GROUP OF SURVEYORS AT A MEETING HELD ON JULY 30, 1997, AND IS ACCEPTED AS THE BEST AVAILABLE EVIDENCE OF THE POSITION OF THE ORIGINAL CORNER.

Ratified by Peer Group in accordance with P.A. 345 of 1990
Van Buren County Surveyor
Date D.R.G. 12/18/97

C. Description of monument for corner and accessories established to perpetuate locating the position of the corner:
G-6 Harrison Marker in Mon Box

S04°W 35.41' Southeast edge of railroad rail fence corner.
N75°W 70.67' Set PK nail & washer in Southerly face of 16" Oak tree.
N03°E 84.17' Set PK nail & washer in West face of 10" Oak tree.
N48°E 79.88' Set PK nail & washer in Southeast face of utility pole.

STATE OF MICHIGAN
JOHN C. HUNT
PROFESSIONAL SURVEYOR
NO. 23513
LICENSED PROFESSIONAL SURVEYOR

Signed by John C. Hunt, P.S. Date December 16, 1997

Surveyor's Michigan License No. 23513

FORM APPROVED BY MICHIGAN STATE BOARD OF LAND SURVEYORS, JAN. 28, 1971
REVISED MAY 14, 1975
REVISED JAN., 1983