

1993

COMMISSION

LAND CORNER RECORDATION CERTIFICATE SEP 23 8 37 AM '93
Filing Requirement of Act 74, Mich. P.A. 1970

For corners in
Hamilton Township
Van Buren County
(County)

Located in: Corner Code -#

Mark A. Smith
VAN BUREN CO.
REGISTER OF DEEDS

- 1. Public Land Survey T 4S R 15W E-1
NW corner Section 4 T ___ R ___
T ___ R ___
T ___ R ___
- 2. Property Controlling S ___ T ___ R ___
in Section S ___ T ___ R ___
- 3. Miscellaneous S ___ T ___ R ___
Property in Sec. S ___ T ___ R ___

Register of Deeds Stamp & File Number

- 4. Lot No. _____, Recorded Plat _____
- 5. Private Claims _____

| | A | B | C | D | E | F | G | H | I | J | K | L | M |
|----|----|---|----|---|----|---|----|---|----|---|----|---|---|
| 2 | 6 | | 5 | | 4 | | 3 | | 2 | | 1 | | |
| 3 | | | | | | | | | | | | | |
| 4 | 7 | | 8 | | 9 | | 10 | | 11 | | 12 | | |
| 5 | | | | | | | | | | | | | |
| 6 | 18 | | 17 | | 16 | | 15 | | 14 | | 13 | | |
| 7 | | | | | | | | | | | | | |
| 8 | 19 | | 20 | | 21 | | 22 | | 23 | | 24 | | |
| 9 | | | | | | | | | | | | | |
| 10 | 30 | | 29 | | 28 | | 27 | | 26 | | 25 | | |
| 11 | | | | | | | | | | | | | |
| 12 | 31 | | 32 | | 33 | | 34 | | 35 | | 36 | | |
| 13 | | | | | | | | | | | | | |

I, Donald R. Gilchrist in a field survey on August 12, 19 93, do hereby certify that under requirements of P.A. 74, Michigan P.A. of 1970, the corner points mentioned in lines 1 and 2 above were in conformance with regulations and rules therefore as required in the current manual of survey instructions of the United States Department of the Interior, Bureau of Land Management or by a decree of a Court of Law and/or that the corner points mentioned in lines 3, 4 and 5 above were in conformance with the rules of the Michigan Board of Land Surveyors or by a Decree of a Court of Law; established, re-established, monumented, re-monumented, recovered, found as expressed below:

NOTE: Not more than 4 corners, all in the same town and range, may be recorded on this certificate.

A. Description of original monument and accessories and/or subsequent restoration:

1/1830 - Government - E.H. Lytle, D.S.
North between Sections 4 & 5 79.24 ch. to intersection North boundary.
Set post at intersection 1.33 ch. (87/78') East of Post.
Witnesses - 9" beech - S 29 Deg E - 26 lks. (17.16')
9" beech - S 58 Deg W - 44 lks. (29.04')

(continued on back of Certificate)


B. Description of corner evidence found and/or method applied in restoring or reestablishing corner:

Fd 1 1/2" axle shaft leaning at 45 Deg E - plumbed up straight - removed
Set Harrison Marker on line at 87.80' - S 89 Deg 25' 03" E - 87.80'
This corner accepted as a careful & faithful perpetuation of original corner
Approved by County Peer Group on 7/28/93

C. Description of monument for corner and accessories established to perpetuate locating the position of the corner:

Harrison Marker
3-6" elms - S 45 Deg E - 24.75' to Pk/W S. side
P.P. - S 15 Deg E - 68.46' Pk/W in W. side
P.P. - N 19 Deg W - 117.78' Pk/W in E. side
CL N & S Rd - W - 59'
SW corner Lawrence Township N 89 Deg 25' 03" W - 87.80'

Signed by Donald R. Gilchrist Date 9/20/93
Surveyor's Michigan License No. R.L.S. 13583

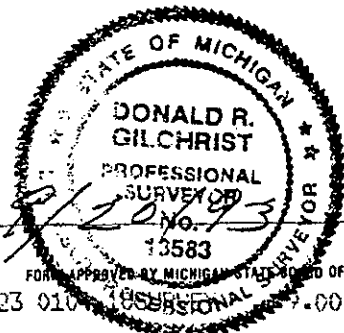

A. Continued from front of Certificate

7/26/1934 - Homer Ward, County Road Eng.

Found broken Crockery, but no other marker. Placed 1 1/4" steel shaft, 1' below surface with collar of stones.

Measured to Lawrence corner 87.8'.

Witnesses - 1" rod with hex nut projecting 6" above surface in fence line S 55 Deg 30' W - 72'.

Drive Shaft 2' above surface of ground N 57 Deg 30'W 66'.

40" Elm - N 81 Deg 30'W - 21.0'.

2/19/1993 - J. C Hunt, P.S.

Recordation Certificate (L3-P284).

7/26/1993 - D. R. Gilchrist, C.S.

Found 1 1/2" steel shaft leaning at a 45 Deg Angle East and no collar of Stones, dug the 3' length of shaft & plumbed straight.

Measured jog distance at 87.37'.

Label 4 Page 35