

1833

COMMISSION

LAND CORNER RECORDATION CERTIFICATE

SEP 23 8 37 AM '93

Filing Requirement of Act 74, Mich. P.A. 1970
County Remonumentation Program

For corners in
Hamilton Township
Van Buren County
(County)

Located In: Corner Code --#

Mark A Smith
VAN BUREN CO
REGISTER OF DEEDS

1. Public Land Survey	T	4S	R	15W	G-1
NE corner Section 4	T		R		
	T		R		
	T		R		
2. Property Controlling	S		T	R	
in Section	S		T	R	
3. Miscellaneous	S		T	R	
Property in Sec.	S		T	R	

Register of Deeds Stamp & File Number

- 4. Lot No. _____, Recorded Plat _____
- 5. Private Claims _____

I, Donald R. Gilchrist in a field survey on _____, 19 93, do hereby certify that under requirements of P.A. 74, Michigan P.A. of 1970, the corner points mentioned in lines 1 and 2 above were in conformance with regulations and rules therefore as required in the current manual of survey instructions of the United States Department of the Interior, Bureau of Land Management or by a decree of a Court of Law and/or that the corner points mentioned in lines 3, 4 and 5 above were in conformance with the rules of the Michigan Board of Land Surveyors or by a Decree of a Court of Law; established, re-established, monumented, re-monumented, recovered, found as expressed below:

NOTE: Not more than 4 corners, all in the same town and range, may be recorded on this certificate.

A	B	C	D	E	F	G	H	I	J	K	L	M
2	6	5	4	3	2	1						
3												
4	7	8	9	10	11	12						
5												
6	18	17	16	15	14	13						
7												
8	19	20	21	22	23	24						
9												
10	30	29	28	27	26	25						
11												
12	31	32	33	34	35	36						
13												

A. Description of original monument and accessories and/or subsequent restoration:

1/1830 - Government Survey - E.H. Lytle, D.S.
 North between Sections 3 & 4 79.16 ch. (5224.56')
 Intersected North boundary 1.58 ch. (104.28') East of Post.
 Set Post at intersection Corner to Sections 3 & 4
 Witnesses: 7" beech - S 51 Deg 30' W - 16 lks. - 10.56'
 9" beech - S 75 Deg E - 44 lks. = 29.04'

(continued on back of Certificate)


B. Description of corner evidence found and/or method applied in restoring or reestablishing corner:

Fd 1/2 Ir in ring of stone & china
 Homer Ward's witnesses checked
 J.C. Hunt's witnesses checked
 This corner accepted as a carefully & faithful perpetuation of the position of the original corner
 Set Harrison Marker in ring of stones & china

C. Description of monument for corner and accessories established to perpetuate locating the position of the corner:

Set Harrison Marker
 18" walnut - North - 27.46' to Pk/W in E. face
 18" walnut - S 15 Deg E - 38.52' to Pk/W in NE face
 36" r.oak - S 35 Deg W - 44.96' to Pk/W in E. face
 20" walnut - N 76 Deg E - 51.95' to Pk/W in S. face
 22" hickory - N 40 Deg W - 61.50' to Pk/W in S. face 4' N of CL Rd
 Job 104.4' W to SE cor Section 33

Signed by Donald R. Gilchrist
 Surveyor's Michigan License No. R.L.S. 13583

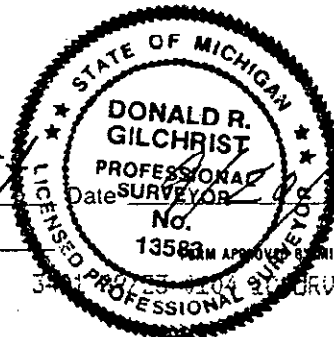

Sheet 4 page 40

12/5/1867 - C.D. Lawton, C.S.
Book 2 - Page 47.

Found NW Corner of Section 3.
Ran Line East to NE Corner of Section 3 79.50 ch. (5247.0'),
Divided and set 1/4 Post midway 39.75 ch. (2623.50').

6/30/1904 - W. H GOSS, C.S.

Found Stake, Earthenware and Stone.

Witnesses: 8" Red Oak - S 24 Deg 15' W - 69 lks. = 45.54'.

16" Sugar - N 65 Deg 45' E - 1.04 ch. = 68.64'.

Measured East 10.17 ch. (671.22'), then 19.61 ch. (1294.26'),
then 10.17 ch. (671.22') to 1/4 Post for Total of
2636.70' and set large Oak Stake midway.

Measured South 19.22 ch. (1268.52') to 1/8 Post being a Stake
& Plow Point, & continued South 19.96 ch. (1317.36') to 1/4
Post being a Stone & Stake for a Total of 2585.88'.

7/12/1934 - H. M. WARD, COUNTY ROAD COMMISSION.

Notes:

Found Stone & Earthenware.

Placed Steel Shaft with Nut up 6" below surface and
surrounded it with a collar of Stones.

Witnesses: 20" Red Oak - S 24 Deg 30' W - 45.5' to Center
Line (same witnesses as Goss).

6" Walnut - North - 27.6' to Center Line.

4" Walnut - N 63 Deg E - 52.3' to Center Line.

8" Ash - S 26 Deg 30' E - 39.6'.

Checked Corner offset as 104.3'.

6/15/1992 - J. C. HUNT, P.S.

Recorded Survey (L9-P333).

Found 1/2" Iron with Stones around it 4' North of Center
Line of Road E&W and in line with old Road Bed to South.

Witnesses: 18" Walnut - North - 27.5', being a nail in East
face (Ward witness).

20" Walnut - N 75 Deg E - 51.90', being a nail in
South face (Ward witness).

14" Walnut - S 15 Deg E - 65.55', being a nail in
West face.

48" Tree (may be Red Oak) - S 35 Deg W - 46.45',
being a nail in NW face.

Jog Distance - West 104.78' to Stone with "x".