

**SURVEY & REMONUMENTATION**

JUN 29 1995

**VAN BUREN COUNTY REMONUMENTATION PROGRAM**

**LAND CORNER RECORDATION CERTIFICATE**  
Filing Requirement of Act 74, Mich. P.A. 1970

**COMMISSION**

For corners in HAMILTON TWP.

<u>VAN BUREN</u> (County)	Located In:	Corner Code #
1. Public Land Survey	Sec. 13 T 4 S. R 15 W.	M-5
	NE Cor. T R	
	T R	
	T R	
2. Property Controlling in Section	S T R	
	S T R	
3. Miscellaneous Property in Sec.	S T R	
	S T R	
4. Lot No. _____, Recorded Plat _____		
5. Private Claims _____		

**FILED**  
JUN 13 4 19 PM '95

*Mark A. Smith*  
VAN BUREN CO. REGISTER OF DEEDS  
Register of Deeds Stamp & File Number

A	B	C	D	E	F	G	H	I	J	K	L	M
2	6	5	4	3	2	1						
3												
4	7	8	9	10	11	12						
5												
6	18	17	16	15	14	13						
7												
8	19	20	21	22	23	24						
9												
10	30	29	28	27	26	25						
11												
12	31	32	33	34	35	36						
13												

I, John C. Hunt, PS, in a field survey on March 14, 1995, do hereby certify that under requirements of P.A. 74, Michigan P.A. of 1970, the corner points mentioned in lines 1 and 2 above were in conformance with regulations and rules therefore as required in the current manual of survey instructions of the United States Department of the Interior, Bureau of Land Management or by a decree of a Court of Law and/or that the corner points mentioned in lines 3, 4 and 5 above were in conformance with the rules of the Michigan Board of Land Surveyors or by a Decree of a Court of Law; established, re-established, monumented, re-monumented, recovered, found as expressed below:

**NOTE: Not more than 4 corners, all in the same town and range, may be recorded on this certificate.**

A. Description of original monument and accessories and/or subsequent restoration:  
3/1830 GLO: W. Brookfield DS: Ran N. & E. boundary 80 chs & set post cor. to Sec. 12 & 13; wit.: 16" Blk. Ash S62°W 38 lks; 14" Blk. Ash N60°30'W 26 lks. 5/1872 AJ Pierce CS: Ran Town line Sec. 7-4-14, Bk. 4 p.98 & 101: both cor. good stakes. Jog 1.85 chs (122.10'). Old Wit. remain. Set 1/2 post on line bet. cor. from his notes. 4/1873 AJ Teed CS: Bk. 4 p.129, at 1/2 post fd. apparent wit. stump. Set stake. Dug for other tree; fd. roots: testimony agreed. Set stone—is within 1'+ of orig. GLO post. 4/3/1905 WB Goss CS: Iron pipe, stake & stone: Fd. stake. Wit.: 10" Sugar N72°30'E 40 26.4', 6" Elm S74°30'W 8.58'. Meas. 40 chs W to 1/2 post, set 1/8 post at 20 chs, pgs. 80 & 156. Meas. S. to 1/2 post 2639.34'. 1911 WV Ackley CS: Red Bk.: Fd. stone. Wit.: 24" Beech N45°E 55', 6" Walnut S44°E 60'. 81947 TA Smith CS: Survey drawing shows cor. 10/29/1956 WQ Smith CS: Plat of Shady Shores shows 1/2 post to S.

B. Description of corner evidence found and/or method applied in restoring or reestablishing corner: (See sketch on back)  
M-5 Section corner common to Sections 12 & 13, T4S-R15W, Hamilton Twp.  
Found 1" I.P. in centerline shallow drainage ditch. Placed Survey Witness Marker along side.  
Set 1/2" Iron Rod S88°36'36"E 20.00' from NE Corner Section 13 for reference only. Wit. for Reference Corner:  
 N65°W 29.32' Set PK nail & washer in E. face of 5" dia. tree.  
 S80°W 10.12' Set PK nail & washer in N. face of 8" Wild Cherry.  
 N25°E 6.68' Set PK nail & washer in S. face of 15" dia. tree.  
 N26°W 26.02' Set PK nail & washer in E. face of 7" Oak.

THIS GOVERNMENT MONUMENT WAS RESTORED WITH APPROVAL OF THE VAN BUREN COUNTY REMONUMENTATION PEER GROUP OF SURVEYORS AT A MEETING HELD FEBRUARY 15, 1995, AND IS ACCEPTED AS A CAREFUL AND FAITHFUL REESTABLISHMENT OF THE POSITION OF THE ORIGINAL CORNER.


C. Description of monument for corner and accessories established to perpetuate locating the position of the corner:  
M-5 1" Iron Pipe with Survey Witness Marker along side.  
 N30°W 14.02' Set PK nail & washer in E. face of 5" dia. tree.  
 S75°E 10.35' Set PK nail & washer in N. face of 8" dia. Wild Cherry.  
 N75°E 23.70' Set PK nail & washer in S. face of 15" dia. tree.  
 N15°E 21.77' Set PK nail & washer in E. face of 7" dia. Oak.  
 South 120.12', 4' long Range Pole with cap #23513.

Validated by Peer Group in accordance with P.A. 345 of 1990  
 Van Buren County Surveyor

Date S. R. G. K.R.H.

Signed by John C. Hunt, P.S. Date March 31, 1995

Surveyor's Michigan License No. 23513

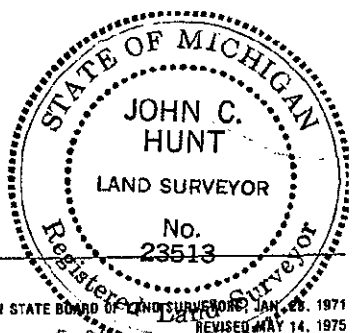



3-14-95  
JOHN HUNT  
P.S. #23513

