

**SURVEY &
REMONUMENTATION**

FILED

VAN BUREN COUNTY REMONUMENTATION PROGRAM

APR 25 1995

**LAND CORNER RECORDATION CERTIFICATE
Filing Requirement of Act 74, Mich. P.A. 1970**

DEC 5 2 48 PM '94

For corners in **COMMISSION**

VAN BUREN

(County)

Located In:

Hamilton Twp.

Corner Code ##

- | | | | |
|-------------------------|------------|-----------------|-------|
| 1. Public Land Survey | Sec. 13 | T 4 S. R 15 W. | M-6 |
| | E 1/2 Post | T _____ R _____ | _____ |
| | | T _____ R _____ | _____ |
| | | T _____ R _____ | _____ |
| 2. Property Controlling | S _____ | T _____ R _____ | _____ |
| in Section | S _____ | T _____ R _____ | _____ |
| 3. Miscellaneous | S _____ | T _____ R _____ | _____ |
| Property in Sec. | S _____ | T _____ R _____ | _____ |

Mark A. Smith
VAN BUREN CO.
REGISTER OF DEEDS

Register of Deeds Stamp & File Number

4. Lot No. _____, Recorded Plat _____
5. Private Claims _____

	A	B	C	D	E	F	G	H	I	J	K	L	M
2	6		5		4		3		2		1		
3													
4	7		8		9		10		11		12		
5													
6	13		17		16		15		14		13		
7													
8	19		20		21		22		23		24		
9													
10	30		29		28		27		26		25		
11													
12	31		32		33		34		35		36		
13													

I, John C. Hunt, P.S., in a field survey on Nov. 28, 19 94, do hereby certify that under requirements of P.A. 74, Michigan P.A. of 1970, the corner points mentioned in lines 1 and 2 above were in conformance with regulations and rules therefore as required in the current manual of survey instructions of the United States Department of the Interior, Bureau of Land Management or by a decree of a Court of Law and/or that the corner points mentioned in lines 3, 4 and 5 above were in conformance with the rules of the Michigan Board of Land Surveyors or by a Decree of a Court of Law; established, re-established, monumented, re-monumented, recovered, found as expressed below:

NOTE: Not more than 4 corners, all in the same town and range, may be recorded on this certificate.

A. Description of original monument and accessories and/or subsequent restoration: 3/1827 GOV. Wm. Brookfield DS, ran N. 40 ch & set E. 1/2 post, wit.: 10" W. Oak S54°W 113 lk, 15" W. Ash N74°30'W 185 lk. 11/1871 A.J. Pierce CS ran both 1/2 lines. 7/13/1905 W.H. Goss CS, fd. old stake & set stake & stones, wit.: 12" Elm N179°W 20 lk, 16" W. Oak N58°E 51 lk. He meas. N. 19.995 ch to 1/8 post stake & cont. N. 19.995 ch (1319.67') to NE cor. totaling 2639.34'. 6/23/1947 T.A. Smith CS, drawing shows cor. w/ distance W. 2650.56' to center 1/2 post. 10/11/1952 W.Q. Smith CS, added to drawing. 10/23/1985 D.R. Gilchrist CS, fd. stone w/ X & wit., meas. W. to center post 2647.07'. 4/6/1989 J.C. Hunt PS, survey drawing shows cor., 4/8/1989, survey drawing shows corner, 1/31/1992 Corner Rec. Cert. L.3 p.225.

B. Description of corner evidence found and/or method applied in restoring or reestablishing corner:
M-6 East quarter post of Sec. 13, T4S-R15W, Hamilton Township.
Corner evidence found: Stone with "x". Replaced with Harrison Marker & placed survey marker "Witness Post" sign alongside.


THIS GOVERNMENT MONUMENT WAS RESTORED WITH APPROVAL OF THE VAN BUREN COUNTY REMONUMENTATION PEER GROUP OF SURVEYORS AT A MEETING HELD ON APRIL 13, 1994, AND IS ACCEPTED AS A CAREFUL AND FAITHFUL PERPETUATION OF THE POSITION OF THE ORIGINAL CORNER.

Restored by Peer Group in
accordance with P.A. 345 of 1990
Van Buren County Surveyor

Date D. R. G. 12/5/94

C. Description of monument for corner and accessories established to perpetuate locating the position of the corner:
M-6 HARRISON MARKER

- S.50°E. 3.30' set PK nail & washer in E. face 9" Ash.
- N.07°E. 15.76' set PK nail & washer in W. face 9" Ash.
- S.80°W. 24.85' set PK nail & washer in N. face of 16" Ash.
- S.24°W. 15.73' set PK nail & washer in NW face of 11" Ash.

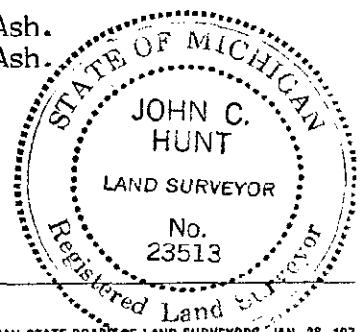

Signed by John C. Hunt, P.S. Date Dec. 1, 1994

Surveyor's Michigan License No. 23513