

1993

DEC 14 9 51 AM '93

LAND CORNER RECORDATION CERTIFICATE

Filing Requirement of Act 74, Mich. P.A. 1970

COMMISSION
For corners in Hamilton Township
Van Buren County (County)

Located In:

Corner Code #

Mark A. Smith
REGISTERED SURVEYOR

1. Public Land Survey	T	4S	R15W	8M
	T		R	
EX Post Section 24	T		R	
	T		R	
2. Property Controlling in Section	S		T	R
	S		T	R
3. Miscellaneous Property in Sec.	S		T	R
	S		T	R

Register of Deeds Stamp & File Number

4. Lot No. _____, Recorded Plat _____
5. Private Claims _____

	A	B	C	D	E	F	G	H	I	J	K	L	I
2	6	5	4	3	2	1							
3													
4	7	8	9	10	11	12							
5													
6	18	17	16	15	14	13							
7													
8	19	20	21	22	23	24							
9													
10	30	29	28	27	26	25							
11													
12	31	32	33	34	35	36							
13													

I, Donald R. Gilchrist a field surveyor on August 25, 1993, do hereby certify that under requirements of P.A. 74, Michigan P.A. of 1970, the corner points mentioned in lines 1 and 2 above were in conformance with regulations and rules therefore as required in the current manual of survey instructions of the United States Department of the Interior, Bureau of Land Management or by a decree of a Court of Law and/or that the corner points mentioned in lines 3, 4 and 5 above were in conformance with the rules of the Michigan Board of Land Surveyors or by a Decree of a Court of Law; established, re-established, monumented, re-monumented, recovered, found as expressed below:

NOTE: Not more than 4 corners, all in the same town and range, may be recorded on this certificate.

A. Description of original monument and accessories and/or subsequent restoration:

3/1827 - GOVERNMENT - William Brookfield, D.S.
Ran North on East boundary of Township - Set 1/4 Section Post
Witnesses: 10" Tam. - South 22 Deg 15' West - 79 lks. (52.14')
14" White Oak - North 49 Deg West - 56 lks. (36.96)
1900± - Red Book - (May be Goss or Ackley)
Used Corner to set Center 1/4 Post on line with West 1/4 Post
by measure
Continued on back of Certificate.

B. Description of corner evidence found and/or method applied in restoring or reestablishing corner:

Dig hole 3' deep - found nothing. Measure from SE Corner Section to Plat Monument on Town Line and continue North to E 1/4 Post (stone/x) Section 13. Divided distance.


Set Harrison Marker marked "Co. Rd. Comm"

Approved at the ^{12/8/93} ~~August 25, 1993~~ Van Buren County Peer Group Meeting and is accepted as a careful and faithful re-establishment of the position of the Original Government Corner.

C. Description of monument for corner and accessories established to perpetuate locating the position of the corner:

Harrison Marker (Co. Rd. Comm)
West 1/4 Post, Section 19, Plat Monument - North 40.78
CL gravel road - East - 9'±
P.P. - North - 7.62' PK/W East side
14" Hem - North 40 Deg West - 72.91' to PK/W North side
3-12" oak - North 15 Deg East - 72.35' to PK/W in South side

LIBER 4 PAGE 108

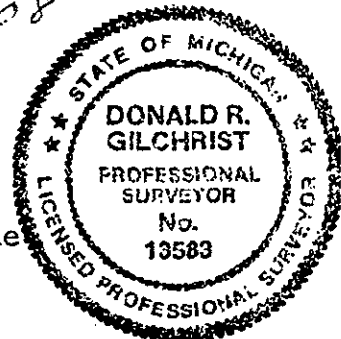

Signed by Donald R. Gilchrist Date 12/11/93

Surveyor's Michigan License No. Donald R. Gilchrist, RLS #13583

A. Continued from front of Certificate

6/12/1939 - T.A. Smith, C.S.

Ran line North from SE Corner to South end of Cyclone Fence - distance 2131.9'

1952 - Supervisor's Plat of Gaertig Subdivision

The West 1/4 Post of Section 19 of Decatur Township is a Plat Monument

6/19/1991 - J.C. Hunt, P.S.

Survey Recorded (L9-P254)

3/24/1992 - Survey Recorded (L9-P310)

5/20/1993 - Don R. Gilchrist, C.S.

Dug a hole 3' deep - found nothing. Ran from Se Corner of Section 24, Hamilton Township, North to East 1/4 Post of Section 13, Hamilton Township (Found stone with "X"). Divided the 1.5 miles proportionally.

Jog distance = 40.78'

Distance to SE corner - 2638.54' (set Harrison Marker marked County Road Commission)

LIBER 4 PAGE 109