

NOV 1 1994

LIGER 4 COMMISSION

LAND CORNER RECORDATION CERTIFICATE Nov 4 4 11 PM '94  
Filing Requirement of Act 74, Mich. P.A. 1970

For corners in Hamilton Township  
Van Buren County (County) Located In: Corner Code #

Mark A. Smith  
VAN BUREN CO.  
REGISTERED PROFESSIONAL SURVEYOR

- 1. Public Land Survey T 4S R 15W M-9  
SE Corner Sec 24 T R  
T R  
T R
- 2. Property Controlling S T R  
in Section S T R
- 3. Miscellaneous S T R  
Property in Sec. S T R
- 4. Lot No. \_\_\_\_\_, Recorded Plat \_\_\_\_\_
- 5. Private Claims \_\_\_\_\_

Register of Deeds Stamp & File Number

	A	B	C	D	E	F	G	H	I	J	K
2	6		5		4		3		2		1
3											
4	7		8		9		10		11		12
5											
6	18		17		16		15		14		13
7											
8	19		20		21		22		23		24
9											
10	30		29		28		27		26		25
11											
12	31		32		33		34		35		36
13											

I, Donald R. Gilchrist in a field survey on October 13, 1994 do hereby certify that under requirements of P.A. 74, Michigan P.A. of 1970, the corner points mentioned in lines 1 and 2 above were in conformance with regulations and rules therefore as required in the current manual of survey instructions of the United States Department of the Interior, Bureau of Land Management or by a decree of a Court of Law and/or that the corner points mentioned in lines 3, 4 and 5 above were in conformance with the rules of the Michigan Board of Land Surveyors or by a Decree of a Court of Law; established, re-established, monumented, re-monumented, recovered, found as expressed below:

NOTE: Not more than 4 corners, all in the same town and range, may be recorded on this certificate.


A. Description of original monument and accessories and/or subsequent restoration:  
3/1827 - Government - Wm. Brookfield, DS, N on E boundary of Section 25 a distance of 80.00 chs (5280.0') and set Post Corner between Sections 24 & 25. Witnesses: 11" white oak - S 6° W 73 lks (48.18'); 14" yellow oak - N 32°30' W 93 lks (61.38'). Red Book (no date) shows long stone (maybe Goss). Witnesses: 8" white oak - NE 72 lks (47.52'); 15" cherry - NW 116.5 lks (76.89'). Later - shows Pipe. Witness: 15" cherry - N 65° W 116.5 lks (76.89'). Note Book - W.H. Goss, CS (no date) pipe and stone. Witnesses: 8" white oak - NE 71 lks (47.52'); 15" cherry - NW 116.5 lks (76.89').

B. Description of corner evidence found and/or method applied in restoring or reestablishing corner:  
Found 120 P spike over a bolt.

Approved at the 6/29/94 Van Buren County Peer Group Meeting and is accepted as a careful and faithful perpetuation of the position of the Original Government Corner.

Ratified by Peer Group in accordance with P.A. 345 of 1990  
Van Buren County Surveyor  
Date 11/4/94

C. Description of monument for corner and accessories established to perpetuate locating the position of the corner:  
Set 1" slimline Harrison Marker in Monument Box  
P.Pole S 20° W 38.82' PK/W in E side  
P.Pole S 60° W 111.79' PK/W in N side  
P.Pole N 20° W 54.13' PK/W in E side  
CL M-51 North on Li - 27'  
Jog - North 39.97' to Decatur corner

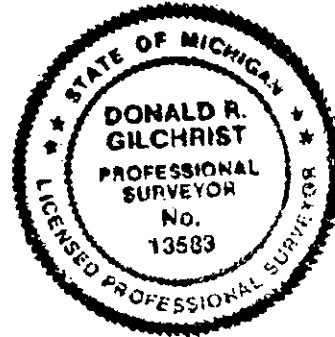

Signed by Donald R. Gilchrist Date 11/4/94

Surveyor's Michigan License No. Donald R. Gilchrist, RLS #13583

94-786

Continued from Front of Certificate

A. 6/10/1940 - T. A. Smith, C.S.

Survey Drawing showing Corner.

Distance West of 413.5' fixed by a Survey by Goss in 1920.

9/12/1945 - Drawing showing Cyclone Fence on Town Line North of Lake of the Woods Drive.

1953 - Michigan Department of Transportation.

Plans show Corner.

9/22/1971 - W. Q. Smith, C.S. (Dennis Middleton, R.L.S.).

Recordation Certificate (Liber 1 - Page 196).

6/19/1991 - J. C. Hunt, P.S.

Recorded Survey (Liber 9 - Page 254).

3/24/1992 - Recorded Survey (Liber 9 - Page 310).

5/1993 - D. R. Gilchrist, C.S.

Used Corner in Survey of Section 24.

Measured West 2651.16' (MDOT 2650.70'), and continued West 1319.90' to Iron in Monument Box, and continued West 1319.37' to Iron in Monument Box.

Measured North 2638.54' to an approved (by Van Buren County Peer Group) Harrison Marker at East Quarter Post.