

DEC 9 10 42 AM '94

LAND CORNER RECORDATION CERTIFICATE
Filing Requirement of Act 74, Mich. P.A. 1970
VAN BUREN COUNTY REMONUMENTATION

For corners in KEELER TWP.
VAN BUREN
(County)

Located in: Corner Code #

1. Public Land Survey W 1/4 Cor. Sec. 6	T 4S R 16W	A-2
	T R	
	T R	
	T R	
2. Property Controlling in Section	S T R	
	S T R	
3. Miscellaneous Property in Sec.	S T R	
	S T R	

Mark A. Smith
VAN BUREN CO
REGISTERED PROFESSIONAL

7-00

12/09 0101 105URVEY 8996

LIBER 4 PAGE 220

Register of Deeds Stamp & File Number

- 4. Lot No. _____, Recorded Plat _____
- 5. Private Claims _____

I, Dale L. Kesler, in a field survey on December 1, 1994, do hereby certify that under requirements of P.A. 74, Michigan P.A. of 1970, the corner points mentioned in lines 1 and 2 above were in conformance with regulations and rules therefore as required in the current manual of survey instructions of the United States Department of the Interior, Bureau of Land Management or by a decree of a Court of Law and/or that the corner points mentioned in lines 3, 4 and 5 above were in conformance with the rules of the Michigan Board of Land Surveyors or by a Decree of a Court of Law, established, re-established, monumented, re-monumented, recovered, found as expressed below:

NOTE: Not more than 4 corners, all in the same town and range, may be recorded on this certificate.

A	B	C	D	E	F	G	H	I	J	K	L	M
2	6	5	4	3	2	1						
3												
4	7	8	9	10	11	12						
5												
6	18	17	16	15	14	13						
7												
8	19	20	21	22	23	24						
9												
10	30	29	28	27	26	25						
11												
12	31	32	33	34	35	36						
13												

A. Description of original monument and accessories and/or subsequent restoration:

3/1827 - GOVERNMENT - William Brookfield, D.S.; West boundary in Van Buren County ran N. 40.00 Chs. (2640.0'), & continued N. 32.54 chs. (2147.64') to corner for a total of 4787.64'. Berrien County side from Quarter Post N. was 33.63 chs. (2219.58'). Jog is 71.94'. 12/10/1890 - F.P. Lawton, C.S.; Book 5 - Page 38. Shows stone at SW Corner & NW corner. 9/11/1990 - G. Mitchell, P.S. - Section 1, T.4S., R.17W. (Bainbridge Twp.). Survey drawing shows E. Quarter Post as a 1.5" Pipe, and Railroad Spike - North 71.92'.

B. Description of corner evidence found and/or method applied in restoring or reestablishing corner:

Found Railroad Spike. Accepted the Railroad spike as best evidence of Corner. Approved at the 11/30/94 Van Buren County Peer Group meeting and this position not established by original Government Surveyors. This monument is accepted as the best available evidence of the position of the corner.


Ratified by Peer Group in accordance with P.A. 345 of 1990
Van Buren County Surveyor

Date D. R. J. 12/8/94

C. Description of monument for corner and accessories established to perpetuate locating the position of the corner:

Set Harrison Marker in monument box.

- 6" Pine tree - N. 38° 21' E. - 59.90' - Nail & washer - West side
- 8" Pine tree - N. 51° 27' E. - 45.20' - Nail & washer - West side
- Power Pole - N. 25° 37' W. - 80.40' - Nail & washer - East side
- E 1/4 Corner, Section 1, T.4 S., R. 17 W. - Record in Liber 3, Page 124, Berrien County Records - South 71.94'

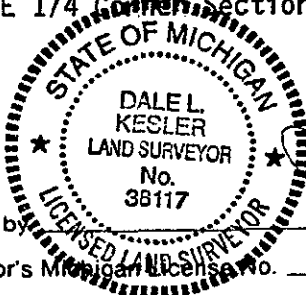

Signed by Dale L. Kesler Date 12-8-94
Surveyor's Michigan License No. No. 38117