

DEC 6 1 48 PM '94

LAND CORNER RECORDATION CERTIFICATE
Filing Requirement of Act 74, Mich. P.A. 1970

For corners in Keeler Township
Van Buren County
(County)

Mark A. Smith
VAN BUREN CO
REGISTERED SURVEYOR

	Located In:	Corner Code #
1. Public Land Survey N1/4 Section 4	T 4S R 16W	F-1
	T R	
	T R	
	T R	
2. Property Controlling in Section	S T R	
	S T R	
3. Miscellaneous Property in Sec.	S T R	
	S T R	

Register of Deeds Stamp & File Number

4. Lot No. _____, Recorded Plat _____
5. Private Claims _____

	A	B	C	D	E	F	G	H	I	J	K	L
2	6	5	4	3	2	1						
3												
4	7	8	9	10	11	12						
5												
6	18	17	16	15	14	13						
7												
8	19	20	21	22	23	24						
9												
10	30	29	28	27	26	25						
11												
12	31	32	33	34	35	36						
13												

I, Donald R. Gilchrist in a field survey on November 8, 1994, do hereby certify that under requirements of P.A. 74, Michigan P.A. of 1970, the corner points mentioned in lines 1 and 2 above were in conformance with regulations and rules therefore as required in the current manual of survey instructions of the United States Department of the Interior, Bureau of Land Management or by a decree of a Court of Law and/or that the corner points mentioned in lines 3, 4 and 5 above were in conformance with the rules of the Michigan Board of Land Surveyors or by a Decree of a Court of Law; established, re-established, monumented, re-monumented, recovered, found as expressed below:

NOTE: Not more than 4 corners, all in the same town and range, may be recorded on this certificate.

A. Description of original monument and accessories and/or subsequent restoration:

B6 - P48 - 8/1900 G. Mutchler, C.S.

See History on Reverse Side

B. Description of corner evidence found and/or method applied in restoring or reestablishing corner:

FD decayed stake & stone, took pictures

Approved at the November 2, 1994 Van Buren County Peer Group Meeting and is accepted as a careful and faithful re-establishment of the position of the Original Government Corner.

Set Harrison Marker over stake in Mon Box, PK Nail 2' E & 2' S

C. Description of monument for corner and accessories established to perpetuate locating the position of the corner:

Slim line Harrison Marker in Mon Box

- 4" W. Ch - S5W - 20.71'
- 2" Elm - S45E - 54.86'
- 4" W. Ch Stump - N35E - 43.51'
- 1' S Center line Road
- 2' W. fenceline South

Retified by Peer Group in accordance with P.A. 345 of 1990
Van Buren County Surveyor

Date J. R. S. 12/6/94



Signed by Donald R. Gilchrist Date 12/5/94
Surveyor's Michigan License No. Donald R. Gilchrist, RLS #13583

Sheet 4 Page 2/4

DEC 6 1 48 PM '94

LAND CORNER RECORDATION CERTIFICATE
Filing Requirement of Act 74, Mich. P.A. 1970

For corners in Keeler Township
Van Buren County
(County)

Located In: Corner Code #

Mark A. Smith
VAN BUREN CO.
REGISTER OF DEEDS

1. Public Land Survey N1/4 Section 4	T	4S	R	16W	Feet
	T		R		
	T		R		
	T		R		
2. Property Controlling in Section	S		T		
	S		T		
3. Miscellaneous Property in Sec.	S		T		
	S		T		

Register of Deeds Stamp & File Number

4. Lot No. _____, Recorded Plat _____
5. Private Claims _____

	A	B	C	D	E	F	G	H	I	J	K	L	M
2		6		5		4		3		2		1	
3													
4		7		8		9		10		11		12	
5													
6		18		17		16		15		14		13	
7													
8		19		20		21		22		23		24	
9													
10		30		29		28		27		26		25	
11													
12		31		32		33		34		35		36	
13													

Donald R. Gilchrist November 8 1994

I, _____ in a field survey on _____, 19____, do hereby certify that under requirements of P.A. 74, Michigan P.A. of 1970, the corner points mentioned in lines 1 and 2 above were in conformance with regulations and rules therefore as required in the current manual of survey instructions of the United States Department of the Interior, Bureau of Land Management or by a decree of a Court of Law and/or that the corner points mentioned in lines 3, 4 and 5 above were in conformance with the rules of the Michigan Board of Land Surveyors or by a Decree of a Court of Law; established, re-established, monumented, re-monumented, recovered, found as expressed below:

NOTE: Not more than 4 corners, all in the same town and range, may be recorded on this certificate.

A. Description of original monument and accessories and/or subsequent restoration:

B6 - P48 - 8/1900 G. Mutchler, C.S.

See History on Reverse Side

B. Description of corner evidence found and/or method applied in restoring or reestablishing corner:

FD decayed stake & stone, took pictures

Approved at the November 2, 1994 Van Buren County Peer Group Meeting and is accepted as a careful and faithful re-establishment of the position of the Original Government Corner.

Set Harrison Marker over stake in Mon Box, PK.Nail 2' E & 2' S


C. Description of monument for corner and accessories established to perpetuate locating the position of the corner:

Slim line Harrison Marker in Mon Box

- 4" W. Ch - S5W - 20.71'
- 2" Elm - S45E - 54.86'
- 4" W. Ch Stump - N35E - 43.51'
- 1' S Center line Road
- 2' W. fenceline South

Ratified by Peer Group in accordance with P.A. 345 of 1990
Van Buren County Surveyor

Date D. R. A. 12/6/94

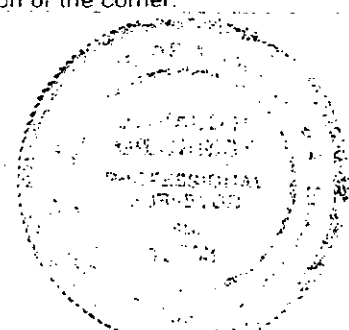

Signed by Donald R. Gilchrist Date 12/5/94
Surveyor's Michigan License No. Donald R. Gilchrist, RLS #13583

