

1833

VAN BUREN COUNTY REMONUMENTATION PROGRAM

LAND CORNER RECORDATION CERTIFICATE Oct 19 11 52 AM '93

Filing Requirement of Act 74, Mich. P.A. 1970

LIBER 4 PAGE 57

COMMISSION

For corners in

Van Buren (County)	Located In: Keeler Twp.	Corner Code #
1. Public Land Survey Sec. 10	T 4 S. R 16 W.	G-4
	T _____ R _____	_____
	T _____ R _____	_____
	T _____ R _____	_____
2. Property Controlling in Section	S _____ T _____ R _____	_____
	S _____ T _____ R _____	_____
3. Miscellaneous Property in Sec.	S _____ T _____ R _____	_____
	S _____ T _____ R _____	_____

Mark A. Smith
VAN BUREN CO.
REGISTER OF DEEDS

Register of Deeds Stamp & File Number

- 4. Lot No. _____, Recorded Plat _____
- 5. Private Claims _____

A	B	C	D	E	F	G	H	I	J	K	L	M
2	6	5	4	3	2	1						
3												
4	7	8	9	10	11	12						
5												
6	18	17	16	15	14	13						
7												
8	19	20	21	22	23	24						
9												
10	30	29	28	27	26	25						
11												
12	31	32	33	34	35	36						
13												

I, John C. Hunt, P.S., in a field survey on July 20, 19 93, do hereby certify that under requirements of P.A. 74, Michigan P.A. of 1970, the corner points mentioned in lines 1 and 2 above were in conformance with regulations and rules therefore as required in the current manual of survey instructions of the United States Department of the Interior, Bureau of Land Management or by a decree of a Court of Law and/or that the corner points mentioned in lines 3, 4 and 5 above were in conformance with the rules of the Michigan Board of Land Surveyors or by a Decree of a Court of Law; established, re-established, monumented, re-monumented, recovered, found as expressed below:

NOTE: Not more than 4 corners, all in the same town and range, may be recorded on this certificate.

A. Description of original monument and accessories and/or subsequent restoration:

3/18/1830 Gov. Survey: EH Lytle DS: N. bet. Sec. 9 & 10 set 1/4 sec. post at 40.00 ch.

Witnesses: 6" Ash N.88°W. 7 lks.; 6" Ironwood N.71°E. 20 lks.

12/1/1870 AJ Pierce CS: Quarter post lost. Bisected the mile & established the 1/4 post 2.5' N. of center of ditch, where supposed before. Set a Walnut stake & brick. Witness: NE cor. of house S.42°W. 1.15 ch. Meas. N. & S. 40.01 1/2 ch. (2646.93').

11/15/1983 JC Hunt PS, used cor. in survey.

B. Description of corner evidence found and/or method applied in restoring or reestablishing corner:

G-4 Quarter corner common to Sections 9 & 10 T4S-R16W, Keeler Twp.

Corner evidence found: 60p spike in C.R. 687 in line with fence E. & downed fence to W.

July 20, 1993, Set Harrison Marker. On July 28, 1993 Monument box set over Harrison Marker.

THIS GOVERNMENT MONUMENT WAS RESTORED WITH APPROVAL OF THE VAN BUREN COUNTY REMONUMENTATION PEER GROUP OF SURVEYORS AT A MEETING HELD ON July 14, 1993, AND IS ACCEPTED AS A CAREFUL AND FAITHFUL REESTABLISHMENT OF THE POSITION OF THE ORIGINAL CORNER.

(See sketch on back.)

C. Description of monument for corner and accessories established to perpetuate locating the position of the corner:


G-4 HARRISON MARKER IN MONUMENT BOX

- West 33.00' 1/2" iron rod w/ cap #25868.
- S.87°W. 39.50' Nail & tag in N. face of 10" dia. tree.
- East 68.92' Nail & tag in S. face of 10" dia. tree.
- N.85°W. 67.60' Nail & tag in N. face of 7" dia. tree.
- N.25°W. 95.17' Nail & tag in E. face pole.

Signed by John C. Hunt, p.s.

Date Oct. 16, 1993

Surveyor's Michigan License No. 23513

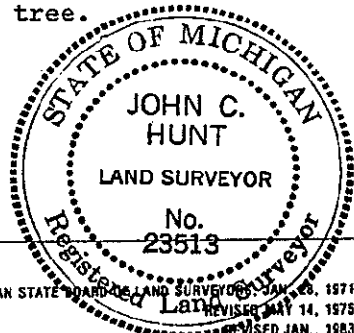

LIBER 4 PAGE 58

