

VAN BUREN COUNTY REMONUMENTATION PROGRAM

LAND CORNER RECORDATION CERTIFICATE  
Filing Requirement of Act 74, Mich. P.A. 1970

Oct 19 11 52 AM '93

LIBER 4 PAGE 66  
1993 COMMISSION

For corners in Van Buren (County) Located in: Keeler Twp. Corner Code # G-6

1. Public Land Survey Sec. 15 T 4 S. R 16 W. G-6  
 T R  
 T R  
 T R

2. Property Controlling in Section S T R  
 S T R

3. Miscellaneous Property in Sec. S T R  
 S T R

4. Lot No. \_\_\_\_\_, Recorded Plat \_\_\_\_\_

5. Private Claims \_\_\_\_\_

Mark A. Smith  
VAN BUREN CO  
REGISTER OF DEEDS

Register of Deeds Stamp & File Number

7.00  
4288 10/19 0101 10SURVEY

I, John C. Hunt, P.S., in a field survey on July 28, 1993, do hereby certify that under requirements of P.A. 74, Michigan P.A. of 1970, the corner points mentioned in lines 1 and 2 above were in conformance with regulations and rules therefore as required in the current manual of survey instructions of the United States Department of the Interior, Bureau of Land Management or by a decree of a Court of Law and/or that the corner points mentioned in lines 3, 4 and 5 above were in conformance with the rules of the Michigan Board of Land Surveyors or by a Decree of a Court of Law; established, re-established, monumented, re-monumented, recovered, found as expressed below:

A	B	C	D	E	F	G	H	I	J	K	L	M
2	6	5	4	3	2	1						
3												
4	7	8	9	10	11	12						
5												
6	16	17	16	15	14	13						
7												
8	19	20	21	22	23	24						
9												
10	30	29	28	27	26	25						
11												
12	31	32	33	34	35	36						
13												

NOTE: Not more than 4 corners, all in the same town and range, may be recorded on this certificate.

A. Description of original monument and accessories and/or subsequent restoration:

3/30/1830 Gov. Survey: EH Lytle DS: N. on sec. line set 1/4 post, wit.: 15" W. Oak S.34°E. 5 lks., 7" W. Oak S.62°W. 20 lks. 7/20/1943, 7/29/1948 TA Smith CS: Drove spike in blk. top rd. C/L in line w/ fence E&W., drove pipe 33' East. Quarter line runs about 30' S. of C/L of 30" Maple E. of road. Meas. N.2652.9' to cor. 1950+- Used found corner; meas. N.40 ch, agreed w/ wit. There is no fence at 1/8 line. 20 ch agrees fairly well w/ hedge row. 2/6/1963 WQ Smith CS: Note shows mon box. 2/8/66 Same. 12/1/70 Note shows fd. bronze cap in mon box. 5/4/73 DA Middleton RLS, fd. bronze cap in mon box & rec. L.2 p.61.

B. Description of corner evidence found and/or method applied in restoring or reestablishing corner:


G-6 Quarter post common to Sections 15 & 16, T4S-R16W, Keeler Township. Corner evidence found: On July 28, 1993, found bronze cap in monument box in C/L of N & S road. At Mar. 24, 1993, meeting of Peer Group of Surveyors, bronze cap in monument box was accepted as found. No Harrison Marker set.

THIS GOVERNMENT MONUMENT WAS RESTORED WITH APPROVAL OF THE VAN BUREN COUNTY REMONUMENTATION PEER GROUP OF SURVEYORS AT A MEETING HELD ON MARCH 24, 1993, AND IS ACCEPTED AS A CAREFUL AND FAITHFUL PERPETUATION OF THE POSITION OF THE ORIGINAL CORNER.

C. Description of monument for corner and accessories established to perpetuate locating the position of the corner:

G-6 BRONZE CAP IN MONUMENT BOX

- N.85°W. 91.35' Nail & tag in S. face of 8" Cherry.
- N.50°W. 96.40' Nail & tag in NE face of 5" Cherry.
- N.80°E. 66.07' Nail & tag in S. face of 9" dia. wood post in grape vineyard.
- N.35°E. 99.87' Nail & tag in W. face of 4" dia. wood post in grape vineyard.

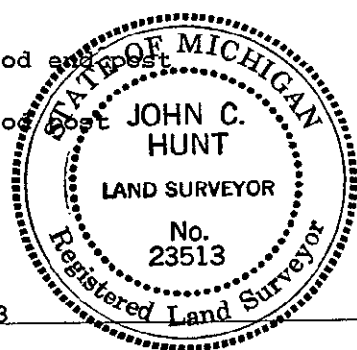

Signed by John C. Hunt, P.S.  
Surveyor's Michigan License No. 23513

Date Oct. 17, 1993