

JAN 1 1999

Dec 1 11 06 AM '98

SECTION

LAND CORNER RECORDATION CERTIFICATE
Filing Requirement of Act 74, Mich. P.A. 1979

Mark A. Smith
VAN BUREN CO.
REGISTERED SURVEYOR

9.00

For corners in Keeler Township


Van Buren (County)	Located In:	Corner Code #
1. Public Land Survey SW Corner, Sec 1	T 4S R 16W	K-3
	T R	
	T R	
	T R	
2. Property Controlling in Section	S T R	
	S T R	
3. Miscellaneous Property in Sec.	S T R	
	S T R	

Register of Deeds Stamp & File Number

12/01 0104 10SURVEY

4. Lot No. _____, Recorded Plat _____
 5. Private Claims _____

I, Donald R. Gilchrist in a field survey on Nov. 17, 1998 do hereby state that under requirements of P.A. 74, Michigan P.A. of 1970, the corner points mentioned in lines 1 and 2 above were in conformance with regulations and rules therefore as required in the current manual of survey instructions of the United States Department of the Interior, Bureau of Land Management or by a decree of a Court of Law and/or that the corner points mentioned in lines 3, 4 and 5 above were in conformance with the rules of the Michigan Board of Land Surveyors or by a Decree of a Court of Law; established, re-established, monumented, recovered, found as expressed below:

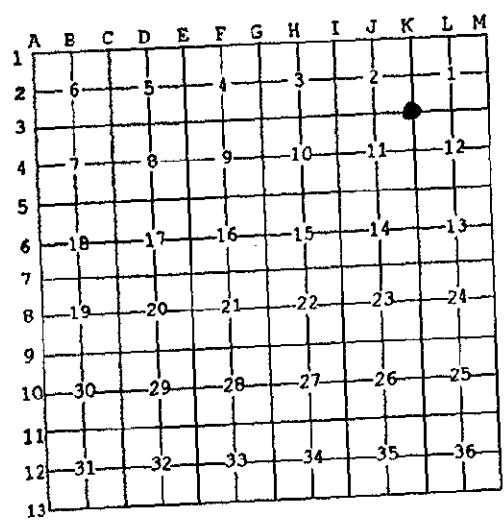

NOTE: Not more than 2 corners, all in the same town and range, may be recorded on this certificate.

A. Description of original monument and accessories and/or subsequent restoration:
 3/1830 - GOVERNMENT - E. H. Lytle, D.S.
 Ran North between Sections 11 & 12 a distance of 80.00 chs. (5280.00') and set post corner.
 Witnesses:
 6" Tamarack - S 68° W - 43 lks. (28.38').
 10" Pine - S 21° E - 45 lks. (29.70').
 Distance East is 39.725 chs. (2621.85'). Distance West is 79.50 chs. (5247.00').
 (Continued on back of Certificate)

B. Description of corner evidence found and/or method applied in restoring or reestablishing corner:
 Found 3/4" pipe over pointed stone with crockery around it. Down 2'.
 Approved at the 7/29/98 Meeting of the Van Buren County Peer Group and is accepted as a careful and faithful perpetuation of the position of the original corner.
 Ratified by Peer Group in accordance with P.A. 345 of 1999
 Van Buren County Surveyor
 Date D. R. S. 12-1-98

C. Description of monument for corner and accessories established to perpetuate locating the position of the corner:
 Removed pipe - Set Harrison Marker over stone - Placed crockery around marker.
 P.P. - S 85° W - 38.18 N/W in South side.
 Post on Power Supply - N 70° W - 70.83' N/W in East side.
 Sign Post - N 65° E - 52.28' N/W in South side.
 Telephone Pedestal - S 85° E - 49.20' to centerline.

Signed by Donald R. Gilchrist
 Surveyor's Michigan License No. RLS 13583

Date 11/30/99



Liber 5 A9131

No Date - Drain Office

Phillips and Walker Drain.

Crosses Section line 9.20 chs. 607.2' West from Section Corner.

3/30/1898 - G. Mutchler, C.S.

Section 12

One witness stump remains.

Witness:

16" White Oak - S 44° 15' E - 1.34 chs. (88.44').

4/12/1982 - John Kamer, P.S. (Wightman & Associates).

Survey drawing shows corner - Found iron.

Distance East is 1315.05'.

Witnesses:

Iron - East - 33.00'.

Nail in Phone Pole - S 85° W - 38.24'.

P.K. Nail in 8" Cherry - N 85° W - 21.64'.

2/1982 - J. C. Hunt, P.S.

Section 1, Notes.

**SURVEY &
REMONUMENTATION**

JAN 11 1999

SECTION