

DEC 28 2 24 PM '94

LAND CORNER RECORDATION CERTIFICATE
Filing Requirement of Act 74, Mich. P.A. 1970

For corners in
HAMILTON TWP.
VAN BUREN
(County)

Located in: Corner Code #

Mark A. Smith
VAN BUREN CO
REGISTER OF DEEDS

- 1. Public Land Survey T-4S R-15W A-13
SW CORNER SEC-31 T 49 R 16W M-13
COMMON TWP COR. T R
HAMILTON & KEELER T R
2. Property Controlling S T R
in Section S T R
3. Miscellaneous S T R
Property in Sec. S T R

Register of Deeds Stamp & File Number

- 4. Lot No. , Recorded Plat
5. Private Claims

Grid table with columns A-L and rows 2-13. Contains numbers 1-36 in a grid pattern.

I, BASIL ADDRESS, in a field survey on DECEMBER 23, 19 94, do hereby certify that under requirements of P.A. 74, Michigan P.A. of 1970, the corner points mentioned in lines 1 and 2 above were in conformance with regulations and rules therefor as required in the current manual of survey instructions of the United States Department of the Interior, Bureau of Land Management or by a decree of a Court of Law and/or that the corner points mentioned in lines 3, 4 and 5 above were in conformance with the rules of the Michigan Board of Land Surveyors or by a Decree of a Court of Law; established, re-established, monumented, re-monumented, recovered, found as expressed below:

NOTE: Not more than 4 corners, all in the same town and range, may be recorded on this certificate.

A. Description of original monument and accessories and/or subsequent restoration:

3/1827 - GOVERNMENT - WILLIAM BROOKFIELD, D.S.
RAN WEST TO RANGE LINE, INTERSECTED 48 LKS (31.68') NORTH OF TEMPORARY SIX MILE POST.
SET POST AT INTERSECTION CORNER OF TOWNS 4 & 5 SOUTH, RANGES 15 & 16 WEST.
WITNESSES: 14" W. OAK S 37DEG-30' E 75 LKS (49.50')
17" W. OAK N 58DEG-15' W 54 LKS (35.64')

RED BOOK - W. H. GOSS, C.S. & TOWNSHIP BOOK BOTH SHOW FOLLOWING: PIPE & STONE
WITNESSES: 30" B. OAK SW 27 LKS (17.82')
24" B. OAK NE 1.55 CHS (102.30')

B. Description of corner evidence found and/or method applied in restoring or reestablishing corner. CONT. ON BACK OF CERTIFICATE

FD. PLOW POINT IN MON. BOX
DIST. WEST TO S 1/4 COR 2660.83'
DIST. WEST TO N-S 1/8 LINE OCC. (NE 1/4 SEC-1, T-5S, R-16W) 1316'+/-
DIST. NORTH TO E 1/4 COR 2637.30' CONT. NORTH TO NE COR 2636.12'

THIS CORNER IS ACCEPTED AS A CAREFUL AND FAITHFUL PERPETUATION OF THE POSITION OF THE ORIGINAL CORNER.


THIS GOVERNMENT MONUMENT WAS RESTORED WITH THE APPROVAL OF THE VAN BUREN COUNTY REMONUMENTATION PEER GROUP OF SURVEYORS. 12-21-94

C. Description of monument for corner and accessories established to perpetuate locating the position of the corner:

REPLACED PLOW POINT WITH HARRISON MONUMENT.

PK & TAG SW SDE PP N 15 W 215.13'
MOST S'LY COR CONC R/W MARKER EAST 59.53'
PK & TAG SW SDE 16" MAPLE S 30 E 118.85'
PK & TAG SE SDE PP S 20 W 151.14'
FD. PK IN S SDE PP S 85 W 51.20'
IN C/L M-51
IN LINE W/ OCC. TO EAST
IN LINE WITH C/L VAN BUREN ST (a.k.a. 96th AVE) TO WEST (C/L OF PAVED APPROACH IS NORTH 15'+/-)

Ratified by Peer Group in accordance with P.A. 345 of 1990
Van Buren County Surveyor
Date 12/28/94 D. P. G.

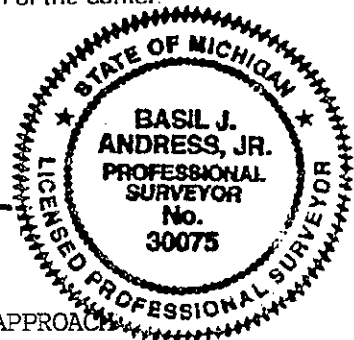

Signed by [Signature] Date 26 Dec 94

Surveyor's Michigan License No. 30075 9536 12/28 0904 10 SURVEYOR STATE BOARD OF LAND SURVEYORS, JAN. 28, 1971

Letter 4 Page 262

CONTINUED FROM FRONT OF CERTIFICATE

A. DESCRIPTION OF ORIGINAL MONUMENT AND ACCESSORIES AND/OR SUBSEQUENT RESTORATION.

1953 - M.D.O.T.

R/W PLAN SHOWS CORNER AS P.I. OF A CURVE AT STATION 296+71.8

1964 - ROBERT W. PRESTINE, R.L.S.

SHOWS MON. BOX

DIST. EAST TO N 1/4 SEC-6, T-5S, R-15W 2473.0 (GOV'T = 2465.1)