

FEB 28 2000

FILE DO NOT MAIL LAND CORNER RECORDATION CERTIFICATE Filing Requirement of Act 74, Mich. P.A. 19

SECTION

For corners in


Liber-30836 Page-43 99590860 12/23/1999 F.E. Youngblood, Wayne Co. Register of Deeds RDANDSYL

WAYNE (County) Located In: NORTHVILLE Corner Code # TOWNSHIP
1. Public Land Survey T 1 S R 8 E C-3
2. Property controlling in Section S T R
3. Miscellaneous Property in Sec. S T R
4. Lot No. Recorded Plat
5. Private Claims

Compliance with ACT 345, P.A. 1990 APPROVED ON: 12-7-99 WAYNE COUNTY REMONUMENTATION PEER GROUP COMMITTEE Register of Deeds Stamp & File Number

I, CHRISTOPHER S. LAMUS, in a field survey on MARCH 2, 19 99, do hereby certify that under requirements of P.A. 74, Michigan P.A. of 1970, the corner points mentioned in lines 1 and 2 above were in conformance with regulations and rules therefore as required in the current manual of survey instructions of the United States Department of the Interior, Bureau of Land Management or by decree of a Court of Law and/or that the corner points mentioned in lines 3,4 and 5 above were in conformance with the rules of the Michigan Board of Land Surveyors or by Decree of a Court of Law; established, re-established, monumented, re-monumented, recovered, found as expressed below:

NOTE: Not more than 4 corners, all in the same town and range, may be recorded on this certificate

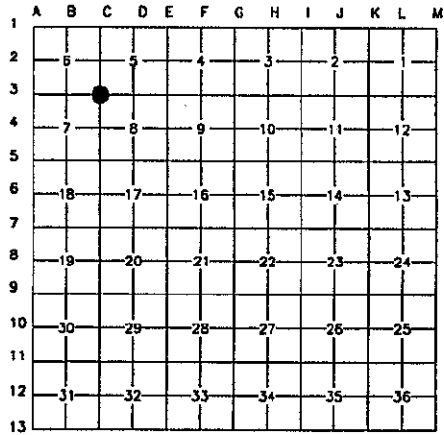

A. Description of original monument and accessories and/or subsequent restoration:

ORIG. GOVERNMENT NOTES 1817 WITNESSED BY FLETCHER - SET POST N 36° W 7 LINKS 24' W.D. (1) S 72° E 34 LINKS 30' SUGAR (2)

NO G.L.D. WITNESSES REMAIN

B. Description of corner evidence and/or method applied in restoring or reestablishing corner:

WAYNE CO. BUREAU OF TAXATION (1930'S) MONUMENT (NO DESCRIPTION) N.W. 52.85' 24' APPLE (3) GONE PUBLIC ACT 74 L.C.R.C. L.18444 P.863 (1973) (C-3) IRON N.E. 44.21' NAIL IN BELL POLE (7) FOUND S.E. 82.73' NAIL IN UTIL. POLE (9) GONE S.W. 56.84' CENTER OF CONS. POWER MARKER (5) FOUND NNW 45.73' NAIL IN 14' MAPLE (4) FOUND
WAYNE CO. ROAD COMMISSION (1970) MONUMENT IN BOX (NO DESCRIPTION) N.W. 45.73' 14' MAPLE (4) FOUND S.W. 56.84' *X* ON CONSUMER POWER MARKER (NO *X* FOUND) (5) FOUND S.E. 82.60' 16' PEAR (6) GONE N.E. 44.21' MBT POLE (7) FOUND PUBLIC ACT 74 L.C.R.C. L.29958 P.4339 (1998) (C-3) FOUND 1/2" IRON ROD IN MONUMENT BOX (RIDGE ROAD AT SEVEN MILE ROAD) N 40° E 44.21' NAIL AND TAG #36491 IN UTILITY POLE (7) FOUND S 70° W 120.06' NAIL AND TAG #36490 IN 48' HICKORY (10) FOUND N 45° W 45.25' NAIL AND TAG #36492 IN 24' MAPLE (11) FOUND

DISTANCE TO D-3 2651.48' (M) RECORDED AS 2651.30' BY WAYNE COUNTY BUREAU OF TAXATION. DISTANCE TO C-4 2640.19' (M) RECORDED AS 2640.05' BY WAYNE COUNTY BUREAU OF TAXATION.

C. Description of monument for corner and accessories established to perpetuate locating the position of the corner:

C-3 (CLOSING CORNER) 1/2" RE-BAR IN MON. BOX. SEVEN MILE HAS BEEN RE-SURFACED W/ NEW MON. BOX. SET BRASS W.C. WASHER AND SURVEYOR'S CAP #41914 OVER 1/2" RE-BAR IN MON BOX. CORNER IS LOCATED IN PAVEMENT OF SEVEN MILE ROAD AT RIDGE ROAD. NORTH 32.94' FOUND 1/2" IRON ROD. (12) N 40° E 44.19' SET W.C. RE-MON BRASS WASHER IN E. SIDE MBT POLE. (7) S 29° W 37.05' NEAR CORNER OF STREET SIGN POST (1' OFF GROUND) (8) S 32° W 56.84' CONS. POWER GAS MARKER POST (FACE TIE) (2' OFF GROUND) (5) S 75° W 120.08' SET W.C. RE-MON BRASS WASHER IN N. SIDE 44' MAPLE. (10) N 45° W 45.46' SET W.C. RE-MON BRASS WASHER IN N.E. SIDE 24' MAPLE. (11)

THE SELECTED LOCATION IS ACCEPTED BY THE CONTRACTOR AND IS GENERALLY ACCEPTED BY PROFESSIONAL SURVEYORS AS THE BEST AVAILABLE EVIDENCE OF THE POSITION OF THE ORIGINAL CORNER.

Signed by Christopher S. Lamus No. 41914 PROFESSIONAL SURVEYOR

Date 12/23/99

R LCR 94R 1Pg A