

\$ 10.00 DEED

\$ 4.00 REMONUMENTATION

DEC 95 3:24 P.M.

RECEI A

LAND CORNER RECORDATION CERTIFICATE
Filing Requirement of Act 74, Mich. P.A. 1970

RECORDED

FOREST E. YOUNGBLOOD, REGISTER OF DEEDS
WAYNE COUNTY, MI

For corners in

WAYNE

(County)

Located in:
PLYMOUTH TWP.

Corner Code #

- 1. Public Land Survey T 1 S R 8 E C-9
T _____ R _____
T _____ R _____
T _____ R _____
- 2. Property controlling S _____ T _____ R _____
in Section S _____ T _____ R _____ SURVEY &
3. Miscellaneous S _____ T _____ R _____ REMONUMENTATION
Property in Sec. S _____ T _____ R _____
- 4. Lot No. _____, Recorded Plat _____
- 5. Private Claims _____ COMMISSION

Compliance with
ACT 345, P.A. 1990


APPROVED ON: 12-13-95
WAYNE COUNTY REMONUMENTATION
PEER GROUP COMMITTEE

Register of Deeds Stamp & File Number

APR 05 1996

I, PAUL V. SCHWIMMER, in a field survey on NOVEMBER 13, 19 95, do hereby certify that under requirements of P.A. 74, Michigan P.A. of 1970, the corner points mentioned in lines 1 and 2 above were in conformance with regulations and rules therefore as required in the current manual of survey instructions of the United States Department of the Interior, Bureau of Land Management or by decree of a Court of Law and/or that the corner points mentioned in lines 3, 4 and 5 above were in conformance with the rules of the Michigan Board of Land Surveyors or by Decree of a Court of Law; established, re-established, monumented, re-monumented, recovered, found as expressed below:

NOTE: Not more than 4 corners, all in the same town and range, may be recorded on this certificate

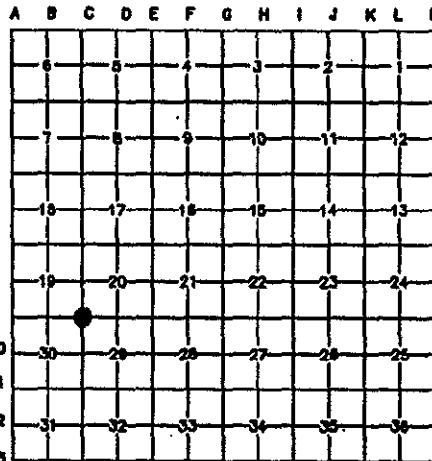

A. Description of original monument and accessories and/or subsequent restoration:

- ORIG. GOVERNMENT NOTES 1815, WITNESSED BOARD OF WAYNE CO. RD. COMM
- BY BALESS JIMMINGS - SET POST (1) IRON FOUND IN 1970 (10)
- ELM 11" S26°E 6 LINKS (2) N.E. 23.85 M.S.H.D. TAG IN 6' ELM (11)
- ELM 7" N71°W 8 LINKS (3) S.E. 146.77 M.S.H.D. TAG IN 15' POPLAR (12)
- WAYNE CO. BUREAU OF TAXATION (1930'S) S.W. 93.77 M.S.H.D. TAG IN DE. POLE (13)
- IRON (4) N.W. 118.26 W.C.R.C. TAG IN DE POLE (14)
- N.E. 28.35 MONUMENT (5)
- S.E. 22.52 MONUMENT (6)
- S.W. 27.76 MONUMENT (7)

CONTINUED ON BACK

B. Description of corner evidence and/or method applied in restoring or reestablishing corner:

C-9 THE IRONS SET PRIOR TO RECONSTRUCTION OF THE RIDGE ROAD OVERPASS WERE DEEPLY BURIED OR DESTROYED. THE CORNER WAS RE-ESTABLISHED BY DANIEL SANDMIERSKI BY A P.K. NAIL IN 1986. SOON AFTER THAT THE FIRM OF ROSKELLY & JEKABSON, INC. PERFORMED A LARGE SURVEY IN THIS AREA AND DISCOVERED TWO P.K. NAILS IN THE CORNER'S VICINITY. USING PRIOR INFORMATION AND MDOIT INFORMATION THEY SET A 5/8" IRON BAR AT A LOCATION THEY FELT WAS CORRECT. THIS POINT BEING 0.7' SLY OF THE TWO P.K.'S. WE AGREE WITH THE TECHNIQUE AND LOCATION AS USED BY ROSKELLY.

C. Description of monument for corner and accessories established to perpetuate locating the position of the corner:


- C-9 SET 1/2" IRON BAR W/ CAP IN MONUMENT BOX. WAYNE CO. REMONUMENTATION
- N20°E 65.00 P.K. NAIL IN GUARD RAIL (21) DISKS WERE PLACED ON
- N50°E 33.49 P.K. NAIL IN GUARD RAIL (22) THE MONUMENT MARKER.
- S25°E 58.20 P.K. NAIL IN GUARD RAIL (23)
- S60°E 28.91 P.K. NAIL IN GUARD RAIL (24)
- S30°W 51.71 P.K. NAIL IN GUARD RAIL (25)
- N60°W 28.62 P.K. NAIL IN GUARD RAIL (27)
- N25°W 59.28 P.K. NAIL IN GUARD RAIL (28)
- N05°E 0.68 FOUND P.K. NAIL (15)

MEASURED DIST TO C-8 IS 2647.35 AND RECORDED IN THE 1930 RESURVEY EFFORT AS 2646.34
MEASURED DIST TO D-9 IS 2513.92 AND RECORDED IN THE 1930 RESURVEY EFFORT AS 2514.61
ROSKELLY DIST TO C-10 MEASURED AT 2638.88 VERSUS 2638.36 AS MEASURED BY MDOIT
THE SELECTED LOCATION IS ACCEPTED BY THE CONTRACTOR AND IS GENERALLY ACCEPTED BY PROFESSIONAL SURVEYORS AS THE BEST AVAILABLE EVIDENCE OF THE POSITION OF THE ORIGINAL CORNER.

Signed by Paul V. Schwimmer

Date 12-15-95

Surveyor's Michigan License No. 24618

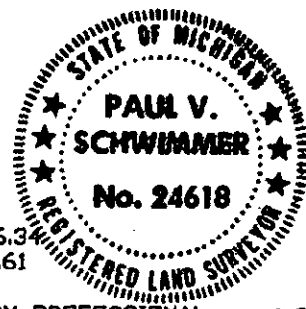

95274745

4R
10D
PJ

ACT 74 SURVEY L22706 PA614
SET P.K. NAIL IN 1986 BY DANIEL SANDMIERSKI (15)
N23°E 64.48 P.K. NAIL IN GUARD RAIL POST (16)
S25°E 58.76 P.K. NAIL IN GUARD RAIL POST (17)
S27°W 52.30 P.K. NAIL IN GUARD RAIL POST (18)
N24°W 58.79 P.K. NAIL IN GUARD RAIL POST (19)

LIBER 28482 PAGE 693

FIELD NOTES FROM ROSKELLY, JEKABSON & ASSOCIATES
SET 5/8" STEEL BAR W/ CAP

N20°E 65.00 P.K. NAIL IN GUARD RAIL (21)
N50°E 33.49 P.K. NAIL IN GUARD RAIL (22)
S25°E 58.20 P.K. NAIL IN GUARD RAIL (23)
S60°E 28.91 P.K. NAIL IN GUARD RAIL (24)
S30°W 51.71 P.K. NAIL IN GUARD RAIL (25)
N60°W 28.62 P.K. NAIL IN GUARD RAIL (27)
N25°W 59.28 P.K. NAIL IN GUARD RAIL (28)
N05°E 0.68 FOUND P.K. NAIL (15)

FILED DO NOT MAIL