

**SURVEY & REMONUMENTATION**

**RC 1544**

APR 25 1995

L127800PA027

**COMMISSION**

**LAND CORNER RECORDATION CERTIFICATE**  
Filing Requirement of Act 74, Mich. P.A. 1970

For corners in

WAYNE  
(County)

Located In:

Corner Code #

1. Public Land Survey	T	<u>1</u>	S	<u>8</u>	E	<u>E-5</u>
	T		R			
	T		R			
	T		R			
2. Property controlling in Section	S		T		R	
	S		T		R	
3. Miscellaneous Property in Sec.	S		T		R	
	S		T		R	
4. Lot No. _____, Recorded Plat _____						
5. Private Claims _____						

Compliance with ACT 345, P.A. 1990

APPROVED ON: 12-21-94 *DBJ*  
WAYNE COUNTY REMONUMENTATION  
PEER GROUP COMMITTEE

Register of Deeds Stamp & File Number

I, PAUL V. SCHWIMMER, in a field survey on DECEMBER 15, 19 94, do hereby certify that under requirements of P.A. 74, Michigan P.A. of 1970, the corner points mentioned in lines 1 and 2 above were in conformance with regulations and rules therefore as required in the current manual of survey instructions of the United States Department of the Interior, Bureau of Land Management or by decree of a Court of Law and/or that the corner points mentioned in lines 3, 4 and 5 above were in conformance with the rules of the Michigan Board of Land Surveyors or by Decree of a Court of Law; established, re-established, monumented, re-monumented, recovered, found as expressed below:

NOTE: Not more than 4 corners, all in the same town and range, may be recorded on this certificate

**A. Description of original monument and accessories and/or subsequent restoration:**

ORIG. GOVERNMENT NOTES 1815, WITNESSED BY BALESS JIMMINGS - SET POST (1)	BOARD OF WAYNE CO. RD. COMM MONUMENT FOUND IN 1970 (9)
SUGAR N77°E 8 LINKS (2)	S.E. 62.90 ED. POLE (10)
SUGAR S74°W 15 LINKS (3)	S.W. 66.13 PBM (11)
WAYNE CO. BUREAU OF TAXATION (1930'S) IRON (4)	S.W. 47.98 MONUMENT (12)
N.E. 50.90 15" MAPLE (5)	N.W. 45.89 FENCE POST (13)
N.E. 70.37 10" MAPLE (6)	ACT 74 RC 119 REC. 12-20-71
S.E. 36.95 CROSS IN BASE OF SIGN (7)	1" IRON IN DIRT ROAD (14)
N.W. 72.10 15" WALNUT (8)	S.W. 47.93 MONUMENT (12)
	S.E. 62.82 TAG IN POLE (10)
	N.E. 72.58 TAG IN POLE (15)
	N.W. 89.71 MBT POLE (16)

ACT 132 SURVEY L18567 P655 ROSKELLY 9-8-73. DRAWING SH FOUND IRON AT SECTION CORNER

BOARD OF WAYNE CO. RD. COMM 1" IRON PIPE FOUND IN 1974 (1) S.E. 62.88 ED. POLE (10) S.W. 66.15 PBM (11) N.W. 90.22 MBT POLE (16) N.E. 72.50 DE. POLE (15)

CONTINUED ON BACK


**B. Description of corner evidence and/or method applied in restoring or reestablishing corner:**

E-5 THIS CORNER TRACKS VERY WELL (EXCEPT FOR THE ACCEPTANCE OF A RANDOM POINT BY PITTS IN 1988). OUR CREW FOUND 1/2" ROD IN A CONC. MONUMENT, 0.25' BELOW THE ROAD SURFACE, PROTECTED BY A MONUMENT BE SINCE THE BOARD OF ROAD COMMISSIONS 1976 WITNESSES STATE THAT THEY "LOWERED THE STONE" WHEN SETTING MONUMENT, WE REGARD THIS AS PERPETUATION OF AN ORIGINAL CORNER.

\$ 16.00 MISCELLANEOUS RECORDING  
28 DEC 94 8:15 A.M. RECEIPT# 4A  
RECORDED  
FOREST E. YOUNGBLOOD, REGISTER OF DEEDS  
WAYNE COUNTY, MI

**C. Description of monument for corner and accessories established to perpetuate locating the position of the corner:**

E-5  
FOUND 1/2" ROD IN CONCRETE MONUMENT W/ A MONUMENT BOX  
N45° E 83.21 SET NAIL W/ WCRC TAG IN POWER POLE  
N70°E 106.27 TOP SPINDLE OF HYDRANT  
S42°E 78.44 SET NAIL W/ WCRC TAG IN POWER POLE  
S50°W 86.59 FOUND IRON W/ CAP #19836  
N42°W 70.84 SET NAIL W/ WCRC TAG IN POWER POLE  
N30°W 107.88 SET NAIL W/ WCRC TAG IN POWER POLE

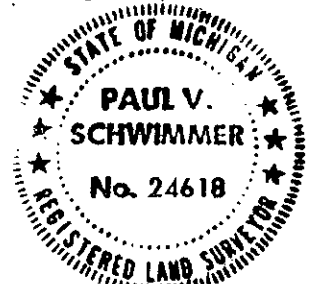

THE SELECTED LOCATION IS ACCEPTED BY THE CONTRACTOR AND IS GENERALLY ACCEPTED BY PROFESSIONAL SURVEYORS AS THE BEST AVAILABLE EVIDENCE OF THE POSITION OF THE ORIGINAL CORNER.

Signed by Paul V. Schwimmer  
Surveyor's Michigan License No. 24618

Date 12/21/94

*2 R  
14 C  
MIS*

750100087511

L127800PA028

BOARD OF WAYNE CO. RD. COMM  
 REPLACED 1" IRON W/ MONUMENT 1976 (17)  
 N61°E 70.35 NAIL 12" MAPLE (18)  
 N49°E 50.97 NAIL 18" MAPLE (19)  
 N21°W 72.90 NAIL 15" MAPLE (20)  
 S51°E 36.92 "X" IN BASE OF SIGN (7)  
 S44°W 47.77 MONUMENT (12)  
 N44°E 47.77 MONUMENT (21)

BOARD OF WAYNE CO. RD. COMM  
 FOUND 3/4" IRON OVER 4" CONC. MONUMENT  
 W/ 1" IRON 3-2-77  
 N.E. 72.59 NAIL IN DE. POLE (15)  
 N.E. 47.77 MONUMENT (21)  
 S.E. 62.84 NAIL IN DE POLE (10)  
 S.W. 66.13 W.C.R.C. PBM 20-20 (11)  
 S.W. 48.00 MONUMENT (12)  
 N.W. 90.25 NAIL IN MBT POLE (16)

NOTE: THIS DOCUMENT SHOWS  
 A 1/2" IRON N.N.E 6.16 FEET  
 AND LIST IT AS A "RANDOM POINT"

ACT 74 RC 926 10-26-88  
 FOUND 1" IRON (ROBERT PITTS)  
 N24°E 66.46 NAIL IN DE. POLE ( )  
 S23°E 67.93 NAIL IN DE. POLE ( )  
 S39°W 54.04 MONUMENT  
 S63°W 45.53 "X" IN WATER M.H.  
 N18°W 90.59 NAIL IN MBT POLE

NOTE: IT APPEARS FROM THE PITTS WITNESSES  
 THAT HE ACCEPTED THE "RANDOM POINT" SHOWN  
 ABOVE INSTEAD OF THE HISTORICAL CORNER.  
 I DID NOT NUMBER HIS WITNESSES FOR INCLUSION  
 TO THIS CORNER.

RC  
 DEPT. OF