

SURVEY & REMONUMENTATION

RC 1545

APR 25 1995

COMMISSION

LAND CORNER RECORDATION CERTIFICATE
Filing Requirement of Act 74, Mich. P.A. 1970

L127800PA029

SEQUENCE #1

For corners in

<u>WAYNE</u> (County)	Located in:	Corner Code #
1. Public Land Survey	T <u>1 S R B E</u>	<u>E-7</u>
	T _____	_____
	T _____	_____
	T _____	_____
2. Property controlling in Section	S _____ T _____	R _____
	S _____ T _____	R _____
3. Miscellaneous Property in Sec.	S _____ T _____	R _____
	S _____ T _____	R _____
4. Lot No. _____, Recorded Plat _____		
5. Private Claims _____		

Compliance with
ACT 345, P.A. 1990


APPROVED ON: 12-21-94

WAYNE COUNTY REMONUMENTATION
DEED GROUP COMMITTEE

Register of Deeds Stamp & File Number

I, PAUL V. SCHWIMMER, in a field survey on DECEMBER 15, 1994, do hereby certify that under requirements of P.A. 74, Michigan P.A. of 1970, the corner points mentioned in lines 1 and 2 above were in conformance with regulations and rules therefore as required in the current manual of survey instructions of the United States Department of the Interior, Bureau of Land Management or by decree of a Court of Law and/or that the corner points mentioned in lines 3,4 and 5 above were in conformance with the rules of the Michigan Board of Land Surveyors or by Decree of a Court of Law; established, re-established, monumented, re-monumented, recovered, found as expressed below:

NOTE: Not more than 4 corners, all in the same town and range, may be recorded on this certificate

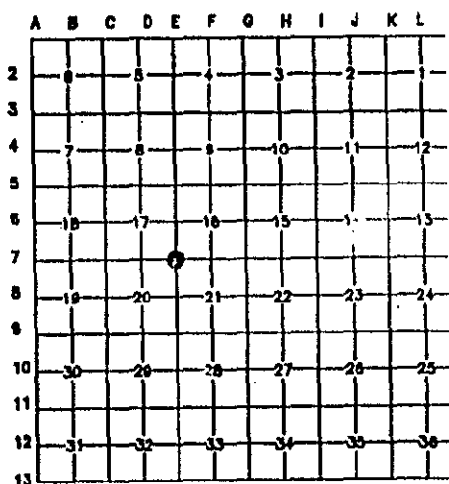

- A. Description of original monument and accessories and/or subsequent restoration:
- DRIG. GOVERNMENT NOTES 1815, WITNESSED BY BALESS JIMMINGS - SET POST (1)
 - ELM 14' S17°W 6 LINKS (2)
 - IRONWOOD 4' N62°E 13 LINKS (3)
 - WAYNE CO. BUREAU OF TAXATION (1930'S)
 - IRON (4)
 - N.E. 48.77 IRON (5)
 - S.E. 37.42 SIGN POST (6)
 - S.E. 1.50 CROSS IN PAVEMENT (7)
 - S.W. 46.80 IRON (8)
 - N.W. 68.40 IRON (9)
 - BOARD OF WAYNE CO. RD. COMM MON. IN BOX FOUND IN 1970 (10)
 - N.E. 47.17 DE POLE (11)
 - S.E. 57.16 MBT POLE (12)
 - S.W. 63.40 MBT. POLE (13)
 - N.W. 79.28 CENTER PBM #20-30 (14)

CONTINUED ON BACK

B. Description of corner evidence and/or method applied in restoring or reestablishing corner:

E-7 THIS CORNER TRACKS VERY WELL FROM 1970 TO PRESENT. WE VERIFIED DISTANCE CHECKS TO D-7 AND E-6 TO TIE IT INTO THE 1930 RESURVEY INFORMATION AND HAVE ACCEPTED IT AS THE CORRECT LOCATION OF THIS CORNER



C. Description of monument for corner and accessories established to perpetuate locating the position of the corner:

- E-7 FOUND BROKEN CONC. MONUMENT W/ 1/2' ROD IN MONUMENT BOX. TOP OF ROD IS 0.15' BELOW TOP OF BOX
- N50°E 72.41 NAIL W/ W.C.R.C. TAG IN POWER POLE
- N70°E 121.31 TOP SPINDLE OF HYDRANT
- S45°E 88.73 TOP SPINDLE OF HYDRANT
- S55°E 74.39 C/L OF WATER GATE VALVE (17)
- S35°E 63.62 NAIL W/ W.C.R.C. TAG IN POWER POLE
- S55°W 87.07 NAIL W/ W.C.R.C. TAG IN POWER POLE
- S50°W 80.21 C/L OF WATER GATE VALVE (18)
- N60°W 76.47 NAIL W/ W.C.R.C. TAG IN POWER POLE
- DIST TO D-7 MEAS @ 2638.58 AND RECORDED AS 2638.47
- DIST TO E-6 MEAS @ 2656.59 AND RECORDED AS 2656.45

\$ 16.00 MISCELLANEOUS RECORDING
28 DEC 94 8:15 A.M. RECEIPT# 40
RECORDED
FOREST E. YOUNGLOOD, REGISTER OF DEEDS
WAYNE COUNTY, MI

THE SELECTED LOCATION IS ACCEPTED BY THE CONTRACTOR AND IS GENERALLY ACCEPTED BY PROFESSIONAL SURVEYORS AS THE BEST AVAILABLE EVIDENCE OF THE POSITION OF THE ORIGINAL CORNER.

Signed by Paul V. Schwimmer
Surveyor's Michigan License No. 24618

Date 12-21-94

2 R
14 D
MISC