

\$ 4.00 REMONUMENTATION

\$ 10.00 DEED

26-DEC 95 3:25 P.M. RECEIVED A

LAND CORNER RECORDATION CERTIFICATE  
Filing Requirement of Act 74, Mich., P.A. 1970

RECORDED  
FOREST E. YOUNGBLOOD, REGISTER OF DEEDS  
WAYNE COUNTY, MI

SEQUENCE # 2

Compliance with  
ACT 345, P.A. 1990

APPROVED ON: 12-13-95  
WAYNE COUNTY REMONUMENTATION  
PEER GROUP COMMITTEE

Register of Deeds Stamp & File Number

LIBER 28482 PAGE 694

For corners in

WAYNE  
(County)

Located In:  
PLYMOUTH TWP

Corner Code #

1. Public Land Survey	T	1	S	R	8	E	E-7
	T			R			
	T			R			
	T			R			
2. Property controlling in Section	S		T		R		SURVEY &
	S		T		R		MONUMENTATION
3. Miscellaneous Property in Sec.	S		T		R		
	S		T		R		

APR 05 1996


COMMISSION

4. Lot No. \_\_\_\_\_, Recorded Plat \_\_\_\_\_  
5. Private Claims \_\_\_\_\_

I, PAUL V. SCHWIMMER, in a field survey on NOVEMBER 13, 1995 do hereby certify that under requirements of P.A. 74, Michigan P.A. of 1970, the corner points mentioned in lines 1 and 2 above were in conformance with regulations and rules therefore as required in the current manual of survey instructions of the United States Department of the Interior, Bureau of Land Management or by decree of a Court of Law and/or that the corner points mentioned in lines 3, 4 and 5 above were in conformance with the rules of the Michigan Board of Land Surveyors or by Decree of a Court of Law; established, re-established, monumented, re-monumented, recovered, found as expressed below:

NOTE: Not more than 4 corners, all in the same town and range, may be recorded on this certificate


- A. Description of original monument and accessories and/or subsequent restoration:
- ORIG. GOVERNMENT NOTES 1815, WITNESSED BY BALESS JIMMINGS - SET POST (1)
  - ELM 14' S17°W 6 LINKS (2)
  - IRONWOOD 4' N62°E 13 LINKS (3)
  - WAYNE CO. BUREAU OF TAXATION (1930'S) IRON (4)
  - N.E. 48.77 IRON (5)
  - S.E. 37.42 SIGN POST (6)
  - S.E. 1.50 CROSS IN PAVEMENT (7)
  - S.W. 46.80 IRON (8)
  - N.W. 68.40 IRON (9)
  - BOARD OF WAYNE CO. RD. COMM MON. IN BOX FOUND IN 1970 (10)
  - N.E. 47.17 DE POLE (11)
  - S.E. 57.16 MBT POLE (12)
  - S.W. 63.40 MBT. POLE (13)
  - N.W. 79.28 CENTER PBM #20-30 (14)

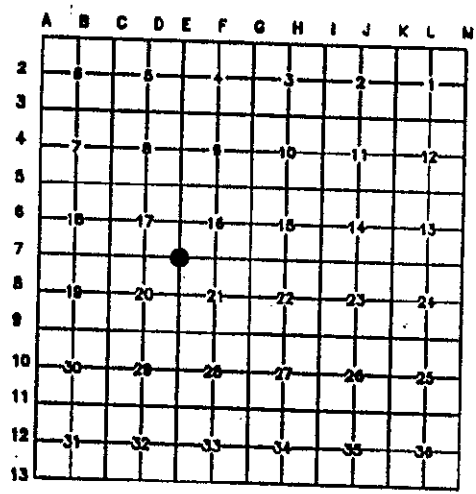

95274746

CONTINUED ON BACK

B. Description of corner evidence and/or method applied in restoring or reestablishing corner:  
E-7 THIS CORNER TRACKS VERY WELL FROM 1970 TO PRESENT. WE VERIFIED DISTANCE CHECKS TO D-7 AND E-6 TO TIE IT INTO THE 1930 RESURVEY INFORMATION AND HAVE ACCEPTED IT AS THE CORRECT LOCATION OF THIS CORNER

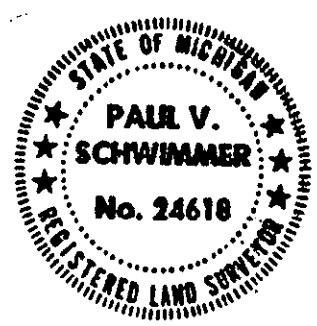

C. Description of monument for corner and accessories established to perpetuate locating the position of the corner:  
E-7 FOUND BROKEN CONC. MONUMENT W/ 1/2" ROD IN MONUMENT BOX. TOP OF ROD IS 0.15' BELOW TOP OF BOX REPLACED WITH NEW 1/2" IRON ROD IN NEW MONUMENT BOX

- N50°E 72.41 NAIL W/ W.C.R.C. TAG IN POWER POLE
- N70°E 121.31 TOP SPINDLE OF HYDRANT
- S45°E 88.73 TOP SPINDLE OF HYDRANT
- S55°E 74.39 C/L OF WATER GATE VALVE (17)
- S35°E 63.62 NAIL W/ W.C.R.C. TAG IN POWER POLE
- S55°W 87.07 NAIL W/ W.C.R.C. TAG IN POWER POLE
- S50°W 80.21 C/L OF WATER GATE VALVE (18)
- N60°W 76.47 NAIL W/ W.C.R.C. TAG IN POWER POLE

WAYNE CO. REMONUMENTATION DISKS WERE PLACED ON THE IRON MARKER.

DIST TO D-7 MEAS @ 2638.58 AND RECORDED IN THE 1930 RESURVEY EFFORT AS 2638.47  
DIST TO E-6 MEAS @ 2565.59 AND RECORDED IN THE 1930 RESURVEY EFFORT AS 2656.45  
THE SELECTED LOCATION IS ACCEPTED BY THE CONTRACTOR AND IS GENERALLY ACCEPTED BY PROFESSIONAL SURVEYORS AS THE BEST AVAILABLE EVIDENCE OF THE POSITION OF THE ORIGINAL CORNER.

Signed by Paul V. Schwimmer  
Surveyor's Michigan License No. 24618

Date 12-15-95

112

ACT 74 SURVEY L18145 PA27?  
FND MONUMENT IN BOX BY JOSEPH COCUZZA  
IN 1971 (10)  
N.W. 79.25 WAYNE CO. PBM (14)  
N.E. 87.06 B.T. FENCE POST (16)  
S.E. 74.35 CENTER WATER GATE (17)  
S.W. 80.30 CENTER WATER GATE (18)

BOARD OF WAYNE CO. RD. COMM  
#4 REBAR IN CONC. (MON. IN BOX) FOUND IN 1977 (10)  
N.E. 47.43 NAIL IN DE POLE (11)  
S.E. 57.14 NAIL IN MBT POLE (12)  
S.W. 63.32 WCRC TAG IN MBT POLE (13)

BOARD OF WAYNE CO. RD. COMM  
#4 REBAR IN CONC. (MON. IN BOX) FOUND IN 1977 (10)  
N.E. 47.42 NAIL IN DE POLE (11)  
S.E. 57.16 NAIL IN MBT POLE (12)  
S.W. 63.33 MBT POLE (13)  
N.W. 79.15 CENTER OF #4 REBAR IN MON. BOX (14)  
N.E. 135.45 NAIL IN DE POLE (19)

ACT 74 SURVEY L19980 PA210  
FND CONC. MON. IN BOX BY RICHARD SWANSON  
IN 1977 (10)  
N.E. 47.42 DE POLE (11)  
S.E. 57.13 MBT POLE (12)  
S.W. 63.31 MBT POLE (13)