

FEB 28 2000

Liber-30836 Page-45  
99590876 12/23/1999  
F.E. Youngblood, Wayne Co. Register of Deeds  
RDANDSYL

FILE DO NOT MAIL

SECTION

LAND CORNER RECORDATION CERTIFICATE

Filing Requirement of Act 74, Mich. P.A. 1970

For corners in

WAYNE (County)	Located In: CITY OF NORTHVILLE	Corner Code #
1. Public Land Survey	T <u>1 S</u> R <u>8 E</u>	<u>G-3</u>
	T _____ R _____	_____
	T _____ R _____	_____
	T _____ R _____	_____
2. Property controlling in Section	S _____ T _____ R _____	_____
	S _____ T _____ R _____	_____
3. Miscellaneous Property in Sec.	S _____ T _____ R _____	_____
	S _____ T _____ R _____	_____
4. Lot No. _____, Recorded Plat _____		
5. Private Claims _____		

Compliance with  
ACT 345, P.A. 1990


APPROVED ON: 12-7-99

WAYNE COUNTY REMONUMENTATION  
PEER GROUP COMMITTEE

Register of Deeds Stamp & File Number

I, CHRISTOPHER S. LAMUS, in a field survey on MARCH 2, 1999, do hereby certify that under requirements of P.A. 74, Michigan P.A. of 1970, the corner points mentioned in lines 1 and 2 above were in conformance with regulations and rules therefore as required in the current manual of survey instructions of the United States Department of the Interior, Bureau of Land Management or by decree of a Court of Law and/or that the corner points mentioned in lines 3,4 and 5 above were in conformance with the rules of the Michigan Board of Land Surveyors or by Decree of a Court of Law; established, re-established, monumented, re-monumented, recovered, found as expressed below:

NOTE: Not more than 4 corners, all in the same town and range, may be recorded on this certificate

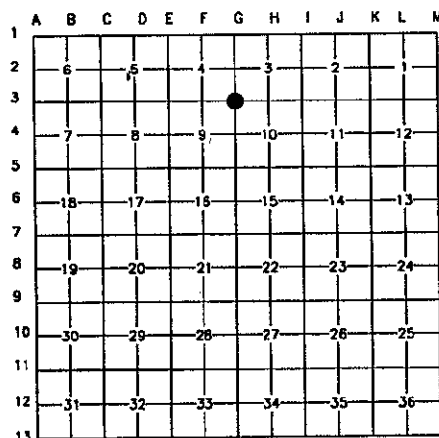

A. Description of original monument and accessories and/or subsequent restoration:

ORIG. GOVERNMENT NOTES 1817  
WITNESSED BY FLETCHER - SET POST  
N 18° W 36 LINKS 11" HICKORY (1)  
S 78.5° E 21 LINKS 11" HICKORY (2)  
NO G.L.D. WITNESSES REMAIN

PUBLIC ACT 74 L.C.R.C. L.22713 P.468 (1985)  
(G-3) FOUND 3/4" I.P. IN MON. BOX  
N.E. 45.40' NAIL/BRASS TAG NW/SIDE GUY POLE. (6) GONE  
S.W. 49.23' NAIL/BRASS TAG NW/SIDE GUY POLE. (7) GONE  
N.W. 70.68' NAIL/BRASS TAG NE/SIDE GUY POLE. (8) GONE

B. Description of corner evidence and/or method applied in restoring or reestablishing corner:

WAYNE CO. BUREAU OF TAXATION (1930'S)  
MONUMENT (NO DESCRIPTION)  
WLY 51.72' X CONC WALL (3) FOUND  
S.W. 21.63' 4" ELM (4) GONE  
NLY 13.89' 4" WILLOW (5) GONE


C. Description of monument for corner and accessories established to perpetuate locating the position of the corner:

G-3  
4" CONC. MON. W/ WAYNE COUNTY REMONUMENTATION WASHER AND A.L.N.M. 24618 CAP  
NORTH 21.77' FOUND SQUARE CONC. MON. "FISHERIES BOUNDARY P.T. 1934"  
N 24° E 27.13' SET W.C. RE-MON BRASS WASHER IN W. SIDE 12" ELM. (9)  
N 65° E 12.76' SET W.C. RE-MON BRASS WASHER IN W. SIDE TWIN 12" BOX ELDER. (10)  
S 19° W 24.46' SET W.C. RE-MON BRASS WASHER IN W. SIDE 14" ASH. (11)  
N 67° W 11.52' SET W.C. RE-MON BRASS WASHER IN W. SIDE 60" WILLOW. (12)  
N 60° W 51.72' FOUND CHISELED "+" ON CONC. WALL. (3)

THE SELECTED LOCATION IS ACCEPTED BY THE CONTRACTOR AND IS GENERALLY ACCEPTED BY PROFESSIONAL SURVEYORS AS THE BEST AVAILABLE EVIDENCE OF THE POSITION OF THE ORIGINAL CORNER.

Signed by Christopher S. Lamus  
Surveyor's Michigan License No. 41914

Date 12/23/99

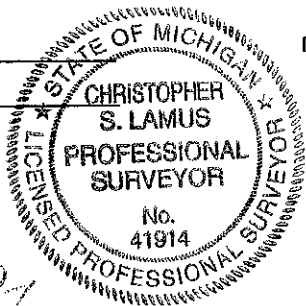

R LCR 94R 1p2 A WP7