

SURVEY & REMONUMENTATION

APR 25 1995

COMMISSION


L27800PA018

RC 1537
LAND CORNER RECORDATION CERTIFICATE
 Filing Requirement of Act 74, Mich. P.A. 1970

For corners in	Located In:	Corner Code #
<u>WAYNE</u> (County)		
1. Public Land Survey	T <u>1 S R B E</u>	<u>G-9</u>
	T _____	_____
	T _____	_____
	T _____	_____
	T _____	_____
2. Property controlling in Section	S _____	_____
	S _____	_____
3. Miscellaneous Property in Sec.	S _____	_____
	S _____	_____
4. Lot No. _____, Recorded Plat _____		
5. Private Claims _____		

Compliance with ACT 345, P.A. 1990
 APPROVED ON: 12-14-94 *[Signature]*
 WAYNE COUNTY REMONUMENTATION PEER GROUP COMMITTEE

Register of Deeds Stamp & File Number

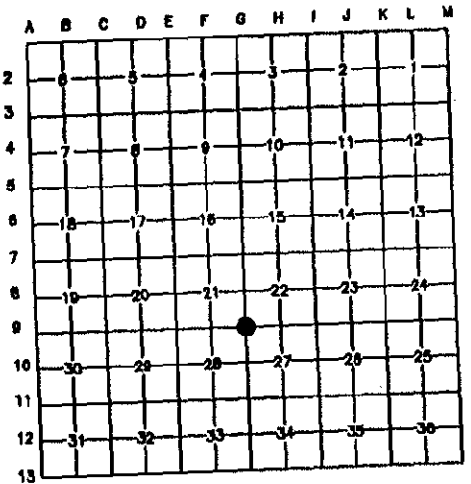

I, PAUL V. SCHWIMMER, in a field survey on DECEMBER 14, 19 94, do hereby certify that under requirements of P.A. 74, Michigan P.A. of 1970, the corner points mentioned in lines 1 and 2 above were in conformance with regulations and rules therefore as required in the current manual of survey instructions of the United States Department of the Interior, Bureau of Land Management or by decree of a Court of Law and/or that the corner points mentioned in lines 3, 4 and 5 above were in conformance with the rules of the Michigan Board of Land Surveyors or by Decree of a Court of Law; established, re-established, monumented, re-monumented, recovered, found as expressed below:

NOTE: Not more than 4 corners, all in the same town and range, may be recorded on this certificate

A. Description of original monument and accessories and/or subsequent restoration:


ORIG. GOVERNMENT NOTES 1815, WITNESSED BY BALESS JIMMINGS - SET POST (1)
 W.D. 30° N81°W 14 LINKS (2)
 IRONWOOD 7° S44°E 4 LINKS (3)
 WAYNE CO. BUREAU OF TAXATION (1930'S) MONUMENT (4)
 N.E. 48.83 30° ELM (5)
 N.E. 199.29 20° ASH (6)
 S.W. 55.60 8° HICKORY (7)

ACT 74 SURVEY L20763 PA912
 FND MONUMENT BY EDWARD ANDERSON IN 1979 (4)
 N5°W 33.61 NAIL IN 8" CHERRY (8) NOTE: WE MEASURED AS N5°E
 S88°W 55.54 MDSH TAG IN 8" WALNUT (9)
 S15°E 26.03 NAIL IN 12" WALNUT (10)
 SHOWN ON SURVEY BY GIFFELS-WEBSTER ENGINEERS INC. IN 1990 L24554 PA018 (4)
 N.E. 10.26 10" WALNUT (11)
 S.E. 18.31 8" BLACK CHERRY (12)
 S.E. 26.12 12" WALNUT (10)
 W. 53.63 ELY CRNR HSE #13620 BERKSHIRE CT. (13)

RC 1537

B. Description of corner evidence and/or method applied in restoring or reestablishing corner:

G-9 FOUND STEEL ENCASED MONUMENT. THIS CORNER TRACKS WELL FROM 1979 TO PRESENT. WE MEASURED THE DISTANCE TO F-9 TO TIE IT INTO THE 1930 RESURVEY EFFORT AND CONCLUDED THAT WE ACCEPT THIS CORNER AS THE LOCATION OF G-9.

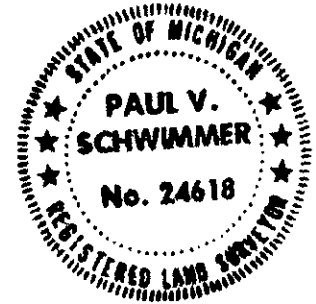

C. Description of monument for corner and accessories established to perpetuate locating the position of the corner:

G-9 FOUND STEEL ENCASED MONUMENT IN RESIDENTIAL YARD.
 N40°E 10.30 NAIL W/ W.C.R.C. TAG IN 12" WALNUT (11)
 N05°E 33.55 NAIL W/ W.C.R.C. TAG IN 12" CHERRY (8)
 S15°E 26.12 NAIL W/ W.C.R.C. TAG IN 14" WALNUT (10)
 N90°W 53.63 EAST CORNER OF HOUSE #13620 BERKSHIRE CT. (13)
 DISTANCE TO F-9 MEAS @ 2620.41 AND RECORDED AS SAME

\$ 13.00 MISCELLANEOUS RECORDING
 28 DEC 94 8:14 A.M. RECEIPT# 4A
 RECORDED
 FOREST E. YOUNGLOOD, REGISTER OF DEEDS
 WAYNE COUNTY, MI

THE SELECTED LOCATION IS ACCEPTED BY THE CONTRACTOR AND IS GENERALLY ACCEPTED BY PROFESSIONAL SURVEYORS AS THE BEST AVAILABLE EVIDENCE OF THE POSITION OF THE ORIGINAL CORNER.

Signed by Paul V. Schwimmer
 Surveyor's Michigan License No. 24618

Date 12-21-94

2 R
 11-D
 MISC