

LAND CORNER RECORDATION CERTIFICATE
Filing Requirement of Act 74, Mich. P.A. 1970

For corners in

WAYNE

(County)

Located In: PLYMOUTH TWP. Corner Code #

- 1. Public Land Survey T 1 S R 8 E G-11
2. Property controlling in Section S T R
3. Miscellaneous Property in Sec. S T R
4. Lot No. , Recorded Plot
5. Private Claims

Compliance with ACT 345, P.A. 1990
APPROVED ON: 12-13-1996
WAYNE COUNTY REMONUMENTATION PEER GROUP COMMITTEE
Register of Deeds Stamp & File Number

96327770

I, CHRISTOPHER S. LAMUS, in a field survey on DECEMBER 16, 1996, do hereby certify that under requirements of P.A. 74, Michigan P.A. of 1970, the corner points mentioned in lines 1 and 2 above were in conformance with regulations and rules therefore as required in the current manual of survey instructions of the United States Department of the Interior, Bureau of Land Management or by decree of a Court of Law and/or that the corner points mentioned in lines 3,4 and 5 above were in conformance with the rules of the Michigan Board of Land Surveyors or by Decree of a Court of Law; established, re-established, monumented, re-monumented, recovered, found as expressed below:

NOTE: Not more than 4 corners, all in the same town and range, may be recorded on this certificate

A. Description of original monument and accessories and/or subsequent restoration:
ORIG. GOVERNMENT NOTES 1815
BY JOSEPH WAMPLER - SET POST
8' SUGAR S.87°E. 10 LINKS (1)
12' ASH S.41°W. 15 LINKS (2)

NO G.L.D. WITNESSES REMAIN

B. Description of corner evidence and/or method applied in restoring or reestablishing corner:

WAYNE CO. BUREAU OF TAXATION (1930'S) PUBLIC ACT 74 L.C.R.C. L.18847, P.819
CONCRETE FENCE POST SET 5/8" IRON PIPE (GONE) FROM EXISTING EXISTING MONUMENTS
N.W. 1.35' 20' ELM (3) GONE FOUND ON BOUNDARY OF RECORDED SUBDIVISION.
S.E. 36.55' 16' ELM (4) GONE
N.W. 11.35' 20' ELM (5) GONE
N.E. 21.25' NAIL IN W. SIDE 8' BASSWOOD (6) GONE
S.W. 5.92' NAIL IN E. SIDE 8' BASSWOOD (7) FOUND
S.E. 21.42' NAIL IN N. SIDE 8' BASSWOOD (8) GONE
N.W. 21.25' NAIL IN W. SIDE 6' BASSWOOD (9) GONE
S.W. 23.91' NAIL IN W. SIDE 8' BASSWOOD (10) FOUND

THE 1930 WITNESS OF A 6" SQUARE POST, WHICH IS STILL PRESENT, AND THE MEASUREED DISTANCE TO G-12 AND G-10 INDICATES THAT THE 5/8" IRON WAS ERRONOUSLY SET, THE FACT THAT IT IS GONE INDICATES THAT A SUBSEQUENT SURVEYOR DISCOVERED THE ERRDR AND REMOVED THE IRON.

DISTANCE TO G-12 2653.92' (M) RECORDED AS 2654.17' BY WAYNE COUNTY BUREAU OF TAXATION.
DISTANCE TO G-10 2653.52' (M) RECORDED AS 2654.44' BY WAYNE COUNTY BUREAU OF TAXATION.

FOUND 6"x6"x6' CONC. FENCE POST AS DESCRIBED.

C. Description of monument for corner and accessories established to perpetuate locating the position of the corner:
G-11

6"x6"x6' CONC. FENCE POST AS DESCRIBED.
UNABLE TO SET W.C. REMON CAP OR SURVEYOR'S CAP DUE TO NATURE OF MONUMENT.
MONUMENT IS NOT LOCATED IN ANY ROAD RIGHT-OF-WAY.


- S.60°E. 26.50' SET W.C. REMON TAG NORTH SIDE OF 24' ELM
S.30°E. 28.90' SET W.C. REMON TAG IN EAST SIDE OF 18' DAK
S.10°E. 6.50' SET W.C. REMON TAG EAST SIDE OF 10' ELM
S.55°W. 30.50' SET W.C. REMON TAG EAST SIDE OF 18' DAK
S.75°W. 22.80' SET W.C. REMON TAG NORTH SIDE OF 10' ELM
N.85°W. 64.50' SET W.C. REMON TAG NORTH SIDE OF 30' DAK
N.25°W. 64.65' S.E. CORNER OF HOUSE #45425 WOODLEIGH WAY

THE SELECTED LOCATION IS A CAREFUL AND FAITHFUL PERPETUATION OF THE POSITION OF THE ORIGINAL CORNER.

Signed by Christopher S. Lamus

Date 12/26/96

Surveyor's Michigan License No. 41914

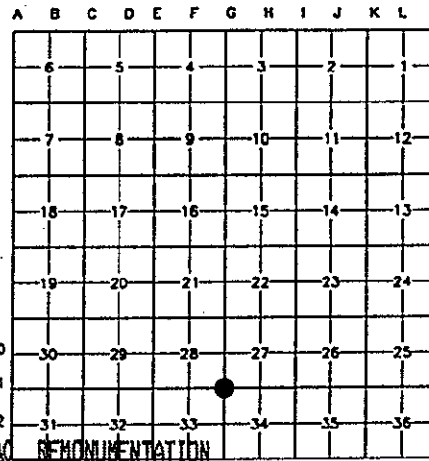

\$ 7.00 DEED
27 DEC 96 11:49 A.M. RECEI A
RECORDED
FOREST E. YOUNGBLOOD, REGISTER EDS
WAYNE COUNTY, MI



4R
7D
D.S.J.