

FEB 28 1994

LI 27059 PA 133

LAND CORNER RECORDATION CERTIFICATE  
Filing Requirement of Act 74, Mich. P.A. 1970


COMMISSION

For corners in

<u>WAYNE COUNTY</u> (County)	Located In:	Corner Code #
1. Public Land Survey	T <u>1S</u> R <u>8E</u>	<u>H7</u>
	T _____ R _____	_____
	T _____ R _____	_____
	T _____ R _____	_____
2. Property Controlling in Section	S _____ T _____ R _____	_____
	S _____ T _____ R _____	_____
3. Miscellaneous Property in Sec.	S _____ T _____ R _____	_____
	S _____ T _____ R _____	_____
4. Lot No. _____, Recorded Plat _____		
5. Private Claims _____		

Compliance with:  
ACT 345, P.A. 1990  
APPROVED ON: 12-21-93 *DPJ*  
WAYNE COUNTY REMONUMENTATION  
PEER GROUP COMMITTEE

Register of Deeds Stamp & File Number

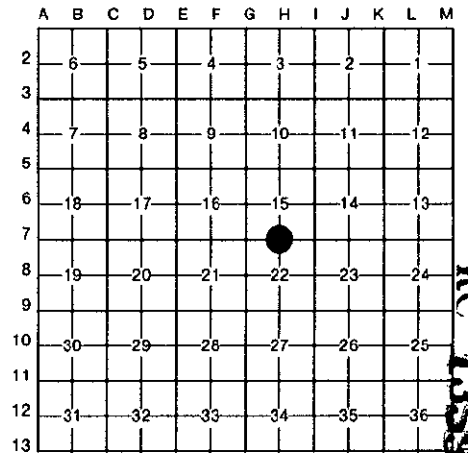


I, RAPHAEL J. LANDINI in a field survey on NOVEMBER 22, 19 93, do hereby certify that under requirements of P.A. 74, Michigan P.A. of 1970, the corner points mentioned in lines 1 and 2 above were in conformance with regulations and rules therefore as required in the current manual of survey instructions of the United States Department of the Interior, Bureau of Land Management or by a decree of a Court of Law and/or that the corner points mentioned in lines 3, 4 and 5 above were in conformance with the rules of the Michigan Board of Land Surveyors or by a Decree of a Court of Law; established, re-established, monumented, re-monumented, recovered, found as expressed below:

NOTE: Not more than 4 corners, all in the same town and range, may be recorded on this certificate.

A. Description of original monument and accessories and/or subsequent restoration:

- |                               |   |
|-------------------------------|---|
| G.L.O. (POST)                 | 1973 MON IN BOX LCRC 253 L18571 P156          |
| SUGAR 6 S78E 25 (16.5) (GONE) | 1979 IRON IN MON BOX LCRC 649 L20407 P483     |
| DO 7 N29W 19 (12.5) (GONE)    | 1989 IRON IN MON BOX LCRC 963 L24497 P253     |
| WPA 1930S (IRON)              | 1990 1/2" ROD IN MON BOX LCRC 978 L24601 P449 |
| MON NE 85.74 (MEAS. 86.32)    |   |
| 10" ELM SW 72.15 (GONE)       |   |
| + BASE                        |   |
| SIGN POST NW 40.13 (GONE)     |   |

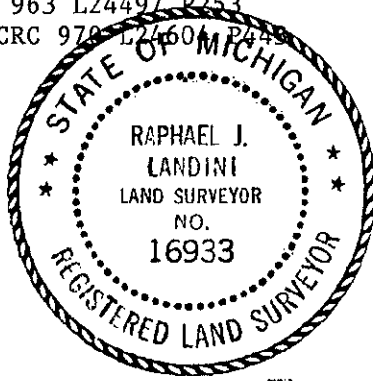

B. Description of corner evidence found and/or method applied in restoring or reestablishing corner:

- |  |    |                                   |
|--|----|-----------------------------------|
| WAYNE COUNTY ROAD COMM. 1970 MON. IN BOX |    |                                   |
| MON                                      | NE | 86.63 (MEAS. 86.32)               |
| MSHD TAG POLE                            | SE | 64.26 (GONE)                      |
| MON                                      | SW | 84.79 (GONE)                      |
| MBT POLE                                 | SW | 80.17 (GONE)                      |
| DE POLE                                  | NW | 82.48 (MEAS. 82.20 TO BE REMOVED) |
| WAYNE COUNTY DPS ROADS 1988              |    |                                   |
| WCRC TAG DE POLE                         | NE | 84.09 (MEAS. 84.01)               |
| WCRC TAG DE POLE                         | SE | 64.55 (GONE)                      |
| WCRC TAG DE POLE                         | SW | 79.96 (GONE)                      |
| WCRC TAG DE POLE                         | SW | 83.40 (GONE)                      |
| WCRC TAG DE POLE                         | NW | 82.20 (MEAS. 82.20 TO BE REMOVED) |

93 DEC 22 AM 10:20  
 FORESTER, YOUNGBLOOD  
 REGISTER OF DEEDS  
 WAYNE COUNTY, MI

C. Description of monument for corner and accessories established to perpetuate locating the position of the corner:

- SET STANDARD 4" DIA. X 36" CONC. MON. WITH 3/8" IRON ROD; SET REMONUMENTATION DISK WITH CAP R.J.L. RLS 16933 IN MON. BOX. SELECTED LOCATION IS ACCEPTED BY CONTRACTOR AND IS GENERALLY ACCEPTED BY PROFESSIONAL SURVEYORS AS THE BEST AVAILABLE EVIDENCE OF THE POSITION OF THE ORIGINAL CORNER.
- |                                   |       |       |
|-----------------------------------|-------|-------|
| FOUND MONUMENT IRON PIPE IN CONC. | N51°E | 86.32 |
| FOUND CAPPED IRON #25828          | N53°E | 85.26 |
| FOUND WCRC TAG NW SIDE DE POLE    | N63°E | 84.01 |
| SET WCR TAG SW SIDE DE POLE       | S42°E | 80.66 |
| FOUND WCRC TAG NW SIDE DE POLE    | S60°W | 73.83 |
| SET WCR TAG NE SIDE DE POLE       | N42°W | 80.13 |

Signed by Raphael J. Landini Date DECEMBER 17, 1993  
 Surveyor's Michigan License No. 16933

*2R*  
*11K*