

FEB 28 2000

SECTION

LAND CORNER RECORDATION CERTIFICATE
Filing Requirement of Act 74, Mich. P.A. 1970


FILE DO NOT MAIL

For corners in

WAYNE (County)	Located In: CITY OF NORTHVILLE	Corner Code #
1. Public Land Survey	T I S R 8 E	I-3
	T _____ R _____	_____
	T _____ R _____	_____
	T _____ R _____	_____
2. Property controlling in Section	S _____ T _____ R _____	_____
	S _____ T _____ R _____	_____
3. Miscellaneous Property in Sec.	S _____ T _____ R _____	_____
	S _____ T _____ R _____	_____
4. Lot No. _____, Recorded Plat _____		
5. Private Claims _____		

Compliance with
ACT 345, P.A. 1990

APPROVED ON: 12-7-99 *DPJ*
WAYNE COUNTY REMONUMENTATION
PEER GROUP COMMITTEE
Register of Deeds Stamp & File Number

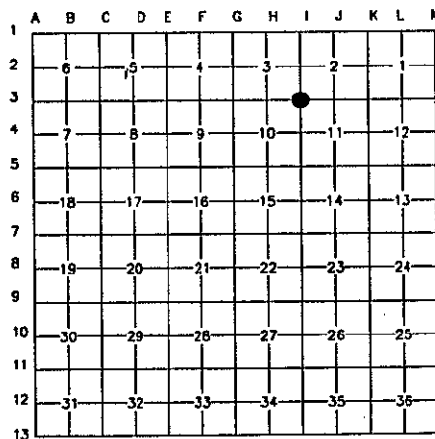

I, CHRISTOPHER S. LAMUS, in a field survey on MARCH 2, 19 99, do hereby certify that under requirements of P.A. 74, Michigan P.A. of 1970, the corner points mentioned in lines 1 and 2 above were in conformance with regulations and rules therefore as required in the current manual of survey instructions of the United States Department of the Interior, Bureau of Land Management or by decree of a Court of Law and/or that the corner points mentioned in lines 3, 4 and 5 above were in conformance with the rules of the Michigan Board of Land Surveyors or by Decree of a Court of Law; established, re-established, monumented, re-monumented, recovered, found as expressed below:

NOTE: Not more than 4 corners, all in the same town and range, may be recorded on this certificate

A. Description of original monument and accessories and/or subsequent restoration:

ORIG. GOVERNMENT NOTES 1817
WITNESSED BY FLETCHER - SET POST
S 71° E 13 LINKS 14" BEECH (1)
N 68.5° W 10 LINKS 10" BEECH (2)

NO G.L.D. WITNESSES REMAIN


B. Description of corner evidence and/or method applied in restoring or reestablishing corner:

WAYNE CO. BUREAU OF TAXATION (1930'S) MON. BOX (NO DESCRIPTION) N.W. 78.38' 13" ELDER (3) GONE WLY 49.10' HYD. (4) GONE S.E. 51.00' 18" ASH (5) GONE N.E. 59.47' ED. POLE (6) GONE	PUBLIC ACT 74 L.C.R.C. L.19028 P.360 (1969) (I-3) FOUND 3/4" BAR IN MONUMENT BOX. WEST 52.03' HYDRANT (11) FOUND N 80° E 88.76' P.K. NAIL IN THE S. FACE OF A POWER POLE (12) FOUND S 37° E 66.65' P.K. NAIL IN THE S.W. FACE OF A POWER POLE (13) FOUND
WAYNE CO. ROAD COMMISSION (1970) MONUMENT (NO DESCRIPTION) N.W. 95.78' MBT POLE W/ WCRC TAG (7) GONE N.W. 29.28' GUARD POST W/ WCRC TAG (8) GONE WLY 38.10' CENTER NUT ON HYD. (9) GONE S.E. 77.62' GUY POLE W/ WCRC TAG (10) GONE	PUBLIC ACT 74 L.C.R.C. L.20965 P.144 (1980) (I-3) FOUND IRON PIPE IN MON BOX N.E. 88.76' PK NAIL IN P. POLE (12) FOUND N.W. 64.27' PK NAIL IN P. POLE (14) FOUND S.E. 66.65' PK NAIL IN P. POLE (13) FOUND

DISTANCE TO I-2 2647.92' (M) RECORDED AS 2648.11' BY ASSESSOR'S NORTHVILLE PLAT NO. 1, L.66, P.45
DISTANCE TO I-2 2647.92' (M) RECORDED AS 2648.34' BY WAYNE COUNTY BUREAU OF TAXATION.
DISTANCE TO J-3 3014.06' (M) RECORDED AS 3012.89' BY WAYNE COUNTY BUREAU OF TAXATION.

C. Description of monument for corner and accessories established to perpetuate locating the position of the corner:

I-3
3/4" IRON ROD IN MON. BOX
SET BRASS W.C. WASHER AND SURVEYOR'S CAP #41914 OVER 3/4" IRON ROD IN MON BOX.
CORNER IS LOCATED IN PAVEMENT OF NORTHVILLE ROAD AND SEVEN MILE ROAD.
N 71° E 88.76' SET W.C. RE-MON BRASS WASHER IN S. SIDE UTILITY POLE. (12)
S 43° E 66.65' SET W.C. RE-MON BRASS WASHER IN S.W. SIDE UTILITY POLE. (13)
S 85° W 52.03' CENTERLINE TOP NUT ON F. HYD. (11)
S 88° W 64.21' SET W.C. RE-MON BRASS WASHER IN E. SIDE UTILITY POLE. (15)
WEST 14.04' FOUND 3/4" IRON ROD IN MON. BOX. (16)
N 37° W 140.03' SET W.C. RE-MON BRASS WASHER IN N.E. SIDE UTILITY POLE. (17)

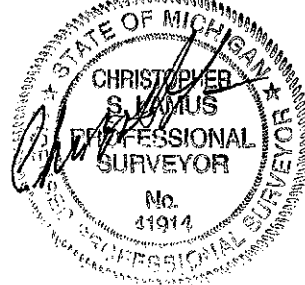

THE SELECTED LOCATION IS ACCEPTED BY THE CONTRACTOR AND IS GENERALLY ACCEPTED BY PROFESSIONAL SURVEYORS AS THE BEST AVAILABLE EVIDENCE OF THE POSITION OF THE ORIGINAL CORNER.

Signed by *Christopher S. Lamus*
Surveyor's Michigan License No. 41914

Date 12/23/99

R LCR 9 4R 1Pg A. DPJ