

LAND CORNER RECORDATION CERTIFICATE  
Filing Requirement of Act 74, Mich. P.A. 1970

For corners in

WAYNE  
(County)

Located In: CITY OF PLYMOUTH Corner Code #

- 1. Public Land Survey      T 1 S R 8 E      I-11  
    T \_\_\_\_\_ R \_\_\_\_\_  
    T \_\_\_\_\_ R \_\_\_\_\_  
    T \_\_\_\_\_ R \_\_\_\_\_
- 2. Property controlling    S \_\_\_\_\_ T \_\_\_\_\_ R \_\_\_\_\_  
    in Section                S \_\_\_\_\_ T \_\_\_\_\_ R \_\_\_\_\_
- 3. Miscellaneous          S \_\_\_\_\_ T \_\_\_\_\_ R \_\_\_\_\_  
    Property in Sec.        S \_\_\_\_\_ T \_\_\_\_\_ R \_\_\_\_\_
- 4. Lot No. \_\_\_\_\_, Recorded Plot \_\_\_\_\_
- 5. Private Claims \_\_\_\_\_

Compliance with  
ACT 345, P.A. 1990 *DOJ*  
**APPROVED ON: 12-13-1996**  
**WAYNE COUNTY REMONUMENTATION**  
**PEER GROUP COMMITTEE**  
 Register of Deeds Stamp & File Number

I, CHRISTOPHER S. LAMUS, in a field survey on DECEMBER 06, 19 96, do hereby certify that under requirements of P.A. 74, Michigan P.A. of 1970, the corner points mentioned in lines 1 and 2 above were in conformance with regulations and rules therefore as required in the current manual of survey instructions of the United States Department of the Interior, Bureau of Land Management or by decree of a Court of Law and/or that the corner points mentioned in lines 3, 4 and 5 above were in conformance with the rules of the Michigan Board of Land Surveyors or by Decree of a Court of Law; established, re-established, monumented, re-monumented, recovered, found as expressed below:

NOTE: Not more than 4 corners, all in the same town and range, may be recorded on this certificate

A. Description of original monument and accessories and/or subsequent restoration:  
 ORIG. GOVERNMENT NOTES 1815  
 BY JOSEPH WAMPLER - SET POST  
 SUGAR 7' UNABLE TO READ BEARING 17 LINKS (1)  
 BEECH 6' UNABLE TO READ BEARING AND DISTANCE (2)

NO G.L.D. WITNESSES REMAIN


B. Description of corner evidence and/or method applied in restoring or reestablishing corner:  
 WAYNE CO. BUREAU OF OF TAXATION (1930'S)  
 NO WITNESSES PUBLISHED

FOUND 1/4" BAR IN CONCRETE INSIDE SQUARE MON. BOX

DISTANCE TO H-11 (NORTH 1/4 OF SEC. 34 AS MONUMENTED) 2618.77' (M) RECORDED AS 2619.28' BY WAYNE COUNTY BUREAU OF TAXATION.  
 DISTANCE TO I-12 2647.59' (M) RECORDED AS 2647.81' BY WAYNE COUNTY BUREAU OF TAXATION.

C. Description of monument for corner and accessories established to perpetuate locating the position of the corner:  
 I-11  
 1/4" IRON BAR IN CONCRETE INSIDE SQUARE MON. BOX.  
 SET W.C. REMON CAP AND SURVEYOR'S CAP # 41914 ON IRON BAR.  
 SECTION CORNER IS LOCATED IN MAIN ST. RIGHT-OF-WAY IN ASPHALT PAVEMENT.

- S.34°E. 64.74' SET W.C. REMON TAG IN PARKING LOT 21.5' NORTH OF N.W. CORNER
- S.32°W. 89.70' N.E. CORNER OF BUILDING #750
- N.84°W. 47.51' S.E. CORNER OF BUILDING #708
- EAST 108.31' S.E. BOLT OF SOUTHERN MOST LIGHT POLE ON PARKING LOT OF
- N.26°W. 19.90' CENTERLINE OF MANHOLE @ SOUTHBOUND LANE OF MAIN ST.

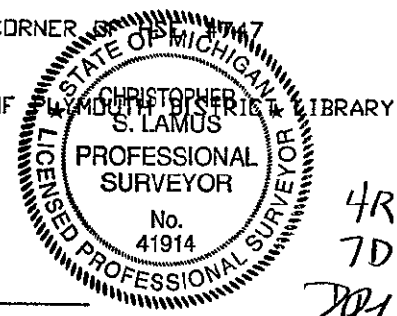

THE SELECTED LOCATION IS A CAREFUL AND FAITHFUL PERPETUATION OF THE POSITION OF THE ORIGINAL CORNER.

Signed by Christopher S. Lamus

Date 12/26/96

Surveyor's Michigan License No. 41914