

**SURVEY & REMONUMENTATION**

**RC 1549**

APR 25 1995

**COMMISSION**

**LAND CORNER RECORDATION CERTIFICATE**  
Filing Requirement of Act 74, Mich. P.A. 1970

**L127800PA037**

For corners in

<u>WAYNE</u> (County)	Located In:	Corner Code #
1. Public Land Survey	T <u>1 S</u> R <u>8 E</u>	<u>I-13</u>
	T _____ R _____	_____
	T _____ R _____	_____
	T _____ R _____	_____
2. Property controlling in Section	S _____ T _____ R _____	_____
	S _____ T _____ R _____	_____
3. Miscellaneous Property in Sec.	S _____ T _____ R _____	_____
	S _____ T _____ R _____	_____
4. Lot No. _____, Recorded Plat _____		
5. Private Claims _____		

Compliance with ACT 345, P.A. 1990  
APPROVED ON: 12-14-94 *DB*  
WAYNE COUNTY REMONUMENTATION  
PEER GROUP COMMITTEE

Register of Deeds Stamp & File Number

	A	B	C	D	E	F	G	H	I	J	K
2	6	5	4	3	2						
3											
4	7	8	9	10	11						
5											
6	15	17	16	15	14						
7											
8	19	20	21	22	23						
9											
10	30	29	28	27	26						
11											
12	31	32	33	34	35						
13											

I, PAUL V. SCHWIMMER, in a field survey on DECEMBER 12, 19 94, do hereby certify that under requirements of P.A. 74, Michigan P.A. of 1970, the corner points mentioned in lines 1 and 2 above were in conformance with regulations and rules therefore as required in the current manual of survey instructions of the United States Department of the Interior, Bureau of Land Management or by decree of a Court of Law and/or that the corner points mentioned in lines 3, 4 and 5 above were in conformance with the rules of the Michigan Board of Land Surveyors or by Decree of a Court of Law; established, re-established, monumented, re-monumented, recovered, found as expressed below:

NOTE: Not more than 4 corners, all in the same town and range, may be recorded on this certificate

A. Description of original monument and accessories and/or subsequent restoration:  
 ORIG. GOVERNMENT NOTES 1815, WITNESSED BY BALESS JIMMINGS - SET POST (1)  
 BEECH 12" S54°E 4 LINKS (2)  
 LYNN 11" N12°W 20 LINKS (3)  
 WAYNE CO. BUREAU OF TAXATION (1930'S) IRON (4)  
 S.E. 26.60 10" LOCUST (5)  
 S.W. 40.37 12" LOCUST (6)  
 S.W. 50.38 18" LOCUST (7)  
 W. 104.02 IRON (8)  
 N.W. 48.57 CROSS IN M.H. FRAME (9)


BOARD OF WAYNE CO. RD. COMM MON IN BOX FOUND IN 1970 (10)  
 N.E. 73.73 DE POLE (11)  
 S.E. 25.82 18" LOCUST (5)  
 S.W. 33.81 10" LOCUST (12)  
 N.W. 60.95 DE POLE (13)  
 SHOWN ON SURVEY CS 42 L17860 PA955  
 FND IRON IN 1971 (14)  
 N.E. 53.11 DE. POLE (11)  
 S.E. 34.77 MBT POLE (15)  
 N.W. 62.71 DE POLE (13)

ACT 74 SURVEY L17860 P/357  
 FND IRON IN MON BOX BY  
 ROBERT CABELL IN 1975 (14)  
 N.E. 53.11 SPIKE IN DE POLE (11)  
 S.E. 34.77 SPIKE IN MBT POLE (15)  
 N.W. 62.71 SPIKE IN DE POLE

CONTINUED ON B/

B. Description of corner evidence and/or method applied in restoring or reestablishing corner:

I-13 FOUND 1/2" IRON ROD IN CONCRETE MONUMENT SET IN A MONUMENT BOX. BASED ON THE CONSISTENCY OF THE MEASUREMENT TO THE CLOSING NW CORNER OF SECTION 2, T2S, R8E, AND WITNESS (11) WE ARE ACCEPTING THE LOCATION OF THIS MONUMENT AS THAT OF I-13. DISTANCES TO I-12 (NLY) AND J-13 (WLY) ARE WELL WITHIN THE LIMITS AS COMPARED TO THE 1930 RESURVEY EFFORT.

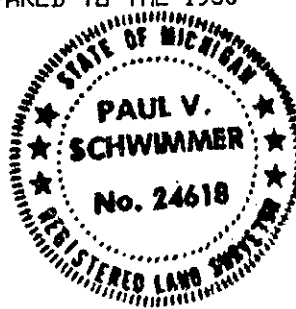

C. Description of monument for corner and accessories established to perpetuate locating the position of the corner:

I-13 FOUND 1/2" ROD IN CONC. MONUMENT SET IN MONUMENT BOX  
 N32°E 92.07 TOP SPINDLE OF HYDRANT  
 N47°E 73.50 NAIL W/ W.C.R.C. TAG IN POWER POLE (11)  
 S56°E 116.84 NAIL W/ W.C.R.C. TAG IN 10" PINE  
 S49°E 76.30 NAIL W/ W.C.R.C. TAG IN POWER POLE  
 S38°W 104.27 N.E. CORNER OF BRICK PUMP HOUSE  
 N87°W 104.43 NW CORNER SECTION 2 T2S, R8E (8)  
 N24°W 112.68 NAIL W/ W.C.R.C. TAG IN 26" MAPLE  
 DIST MEASURED TO I-12 WAS 2646.78 AND RECORDED IN THE 1930 RESURVEY EFFORT AS 2646.32  
 DIST MEASURED TO J-13 WAS 2647.09 AND RECORDED IN THE 1930 RESURVEY EFFORT AS 2647.71

\$ 16.00 MISCELLANEOUS RECORDING  
 28 DEC 94 8:16 A.M. RECEIPT# 4A  
 RECORDED  
 FOREST E. YOUNGBLOOD, REGISTER OF DEEDS  
 WAYNE COUNTY, MI

THE SELECTED LOCATION IS ACCEPTED BY THE CONTRACTOR AND IS GENERALLY ACCEPTED BY PROFESSIONAL SURVEYORS AS THE BEST AVAILABLE EVIDENCE OF THE POSITION OF THE ORIGINAL CORNER.

Signed by Paul V. Schwimmer  
 Surveyor's Michigan License No. 24618

Date 12-21-94

*2R*  
*14-D*  
*MISC*

L127800PA038

BOARD OF WAYNE CO. RD. COMM  
 MONUMENT IN MEN. BOX FOUND 1975 (14)  
 S.E. 25.77 23' LOCUST (5)  
 S.W. 32.50 10' LOCUST (12)  
 N.W. 63.16 DE POLE (13)

1975

127800