

**SURVEY &
REMONUMENTATION**

RC 1539

APR 25 1995

SEQUENCE #1

COMMISSION

LAND CORNER RECORDATION CERTIFICATE
Filing Requirement of Act 74, Mich. P.A. 1970

L127800PA020

For corners in

WAYNE
(County)

Located In:

Corner Code #

1. Public Land Survey	T	1 S	R 8 E	K-5
	T		R	
	T		R	
	T		R	
2. Property controlling in Section	S	T	R	
	S	T	R	
3. Miscellaneous Property In Sec.	S	T	R	
	S	T	R	
4. Lot No. _____, Recorded Plat _____				
5. Private Claims _____				


Compliance with
ACT 345, P.A. 1990

APPROVED ON: 12-14-94 *DPJ*
WAYNE COUNTY REMONUMENTATION
PEER GROUP COMMITTEE

Register of Deeds Stamp & File Number

I, PAUL V. SCHWIMMER, in a field survey on DECEMBER 5, 19 94, do hereby certify that under requirements of P.A. 74, Michigan P.A. of 1970, the corner points mentioned in lines 1 and 2 above were in conformance with regulations and rules therefore as required in the current manual of survey instructions of the United States Department of the Interior, Bureau of Land Management or by decree of a Court of Law and/or that the corner points mentioned in lines 3, 4 and 5 above were in conformance with the rules of the Michigan Board of Land Surveyors or by Decree of a Court of Law; established, re-established, monumented, re-monumented, recovered, found as expressed below:

NOTE: Not more than 4 corners, all in the same town and range, may be recorded on this certificate

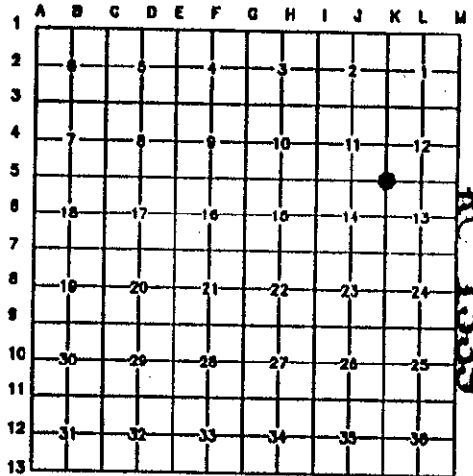

A. Description of original monument and accessories and/or subsequent restoration:

ORIGINAL GOVERNMENT NOTES 1815, SET BY BOARD OF WAYNE CO. RD. COMM 1970	ACT 74 CERTIFICATE FC 539 1977
B. JIMMINGS - SET POST (1)	FOUND IRON IN MON. BOX (4)
HICKORY 10° S19°E 41 LINKS (2)	NLY 46.86 29° ELM (9)
ELM 5° N11°E 18 LINKS (3)	S.E. 60.34 21° ELM (10)
WAYNE CO. BUREAU OF TAXATION (1930'S)	SLY 59.36 DE. POLE (11)
IRON (4)	N.W. 42.81 MI. BELL POLE (8)
S.E. 44.52 18° MAPLE (5)	ACT 74 CERTIFICATE - RC 286 1973
S.W. 29.17 24° MAPLE (6)	FOUND 1' BAR IN MON. BOX (4)
S.W. 73.66 14° MAPLE (7)	N 34°W 42.65 NAIL IN DE. POLE (8)
N.W. 42.74 TEL POLE (8)	S 07°E 58.53 NAIL IN DE. POLE (11)
	S 34°E 59.38 NAIL IN 15' TREE (12)

B. Description of corner evidence and/or method applied in restoring or reestablishing corner:

K-5 FOUND 1' IRON IN MONUMENT BOX 0.6' BELOW THE SURFACE. WE COULD ONLY FIND TWO WITNESSES REMAINING, (4) THE IRON, AND (11). MEASUREMENTS TAKEN TO K-4 AND J-5 VERIFY THE LOCATION OF THIS CORNER BASED ON THE 1930 RESURVEY EFFORT. USING THIS INFORMATION, WE ARE ACCEPTING THE LOCATION OF THE EXISTING IRON AS THAT OF K-5

\$ 13.00 MISCELLANEOUS RECORDING
28 DEC 94 8:14 A.M. RECEIPT# 4A
RECORDED
FOREST E. YOUNGBLOOD, REGISTER OF DEEDS
WAYNE COUNTY, MI

C. Description of monument for corner and accessories established to perpetuate locating the position of the corner:

K-5 FOUND 1' IRON IN A MONUMENT BOX (4)
N05°E 41.45 FD. P.K. NAIL IN CONCRETE W/ #17632
N83°E 281.11 TOP SPINDLE OF HYDRANT
S62°E 152.80 R.R. SPIKE IN D.E. POLE
S10°W 58.58 NAIL W/ W.C.R.C. TAG IN DE POLE (11)
S15°W 60.05' CONCRETE MONUMENT
S73°W 154.66 NAIL W/ W.C.R.C. TAG IN DE POLE
N71°W 173.30 NAIL W/ W.C.R.C. TAG IN DE POLE
N45°W 106.08 S.E. CORNER OF HSE 17103
DIST TO L-5 MEAS @ 2638.17 AND RECORDED AS 2638.13
DIST TO K-4 MEAS AND RECORDED AS 2027.09



THE SELECTED LOCATION IS ACCEPTED BY THE CONTRACTOR AND IS GENERALLY ACCEPTED BY PROFESSIONAL SURVEYORS AS THE BEST AVAILABLE EVIDENCE OF THE POSITION OF THE ORIGINAL CORNER.

Signed by Paul V. Schwimmer
Surveyor's Michigan License No. 24618

Date 12-21-94

2 R
11 D
MISC