

**FILE DO NOT M.**  
**SURVEY &**  
**REMONUMENTATION**

**MAR 17 1998**

**LAND CORNER RECORDATION CERTIFICATE**  
Filing Requirement of Act 74, Mich. P.A. 1970

For corners in **SECTION**  
WAYNE  
(County)

Located in: NORTHVILLE TWP. Corner Code #


- |                                    |   |            |   |            |            |
|------------------------------------|---|------------|---|------------|------------|
| 1. Public Land Survey              | T | <u>1 S</u> | R | <u>8 E</u> | <u>K-6</u> |
|                                    | T |            | R |            |            |
|                                    | T |            | R |            |            |
|                                    | T |            | R |            |            |
| 2. Property controlling in Section | S |            | T |            |            |
|                                    | S |            | T |            |            |
| 3. Miscellaneous Properly in Sec.  | S |            | T |            |            |
|                                    | S |            | T |            |            |
4. Lot No. \_\_\_\_\_, Recorded Plat \_\_\_\_\_
5. Private Claims \_\_\_\_\_

Compliance with  
**ACT 345, P.A. 1990**  
**APPROVED ON: 12-8-97** *DPJ.*  
**WAYNE COUNTY REMONUMENTATION**  
**PEER GROUP COMMITTEE**

Register of Deeds Stamp & File Number

I, CHRISTOPHER S. LAMUS, in a field survey on DECEMBER 3, 19 97, do hereby certify that under requirements of P.A. 74, Michigan P.A. of 1970, the corner points mentioned in lines 1 and 2 above were in conformance with regulations and rules therefore as required in the current manual of survey instructions of the United States Department of the Interior, Bureau of Land Management or by decree of a Court of Law and/or that the corner points mentioned in lines 3,4 and 5 above were in conformance with the rules of the Michigan Board of Land Surveyors or by Decree of a Court of Law; established, re-established, monumented, re-monumented, recovered, found as expressed below:

NOTE: Not more than 4 corners, all in the same town and range, may be recorded on this certificate

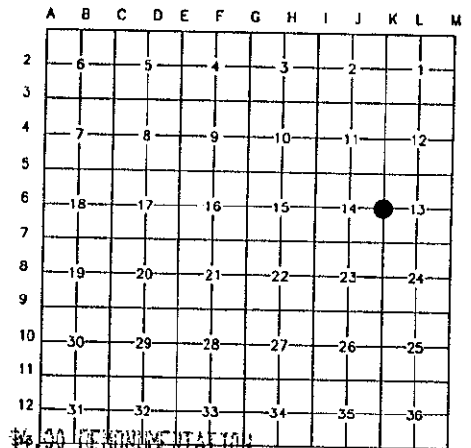

~~\$4.00~~ REMONUMENTATION  
\$7.00 DEED  
\$7.00 DEED  
RECORDED  
FOREST E. YOUNGLOREN, REGISTER OF DEEDS  
WAYNE COUNTY, MI  
Receipt #41914

A. Description of original monument and accessories and/or subsequent restoration:

ORIG. GOVERNMENT NOTES 1815  
BY JOSEPH WAMPLER - SET POST  
12" BEECH S.86°E. 15 LINKS (1)  
11" BEECH S.68°W. 30 LINKS (2)

NO G.L.O. WITNESSES REMAIN

B. Description of corner evidence and/or method applied in restoring or reestablishing corner:

WAYNE CO. BUREAU OF TAXATION (1930'S) FOUND IRON NORTH 0.5' STONE (3) GONE S.W. 18.40' 2 - 4" OAKS (4) GONE	PUBLIC ACT 74 L.C.R.C. L.18638, P.889 FOUND 1" IRON RIPE ENCASED IN CONCRETE AND WITHIN 4" DIA. STEEL CYLINDER N 51°43'00" W 74.52' IRON SPIKE IN 12" TREE (5) S 89°14'00" W 51.54' NAIL IN DETROIT EDISON POLE (6) FOUND S 70°48'00" W 84.50' CORNER OF BRICK HOUSE (7) FOUND
--	--

DISTANCE TO K-5 2734.95' (M) RECORDED AS 2734.98' BY WAYNE COUNTY BUREAU OF TAXATION & 2735.17' (REC) IN NORTHVILLE COMMONS No.5 L.95, P.10, W.C.R.

DISTANCE TO K-7 2976.11' (M) RECORDED AS 2976.02' BY WAYNE COUNTY BUREAU OF TAXATION.

C. Description of monument for corner and accessories established to perpetuate locating the position of the corner:

K-6  
1" IRON PIPE IN CONCRETE ENCASED IN 4" STEEL CYLINDER  
SET SURVEYOR'S CAP #41914 INSIDE 1" IRON PIPE. UNABLE TO SET W.C. REMON CAP DUE TO SIZE OF IRON PIPE.  
MONUMENT IS NOT LOCATED IN ANY ROAD RIGHT-OF-WAY.

- S.85°W. 51.58' SET BRASS W.C. REMON WASHER W/ 10D NAIL IN N.FACE OF DET. ED. POLE
- S.70°W. 84.50' NE COR OF BRICK HOUSE (7)
- S.85°W. 51.57' PK NAIL IN N.FACE OF DET. EDISON P.POLE (6)
- N.54°W. 74.22' SET NAIL IN BRASS WASHER (W.C.R.) IN N.E. FACE OF 30" HARDWOOD.
- S.86°E. 49.58' SW COR OF HOUSE

THE SELECTED LOCATION IS A CAREFUL AND FAITHFUL PERPETUATION OF THE POSITION OF THE ORIGINAL CORNER.

Signed by *Christopher S. Lamus*  
Surveyor's Michigan License No. 41914

Date 12/11/97

