

\$ 4.00 REMONUMENTATION

\$ 10.00 DEED

26 DEC 95 3:25 P.M.

RECEIPT# 76A

LAND CORNER RECORDATION CERTIFICATE

Filing Requirement of Act '74, Mich. P.A. 1970

RECORDED  
FOREST E. YOUNGBLOOD, REGISTER OF DEEDS  
WAYNE COUNTY, MI

For corners in

WAYNE  
(County)

Located In: PLYMOUTH Twp

Corner Code # L-11

1. Public Land Survey	T	1 S	R	8 E	
	T		R		
	T		R		
	T		R		
	T		R		
2. Property controlling in Section	S		T		
	S		T		
3. Miscellaneous Property in Sec.	S		T		
	S		T		

4. Lot No. \_\_\_\_\_, Recorded Plat \_\_\_\_\_

5. Private Claims \_\_\_\_\_


Compliance with ACT 345, P.A. 1990

APPROVED ON: 12-13-95  
WAYNE COUNTY REMONUMENTATION  
PEER GROUP COMMITTEE

Register of Deeds Stamp & File Number

95274749

APR 05 1996  
COMMISSION

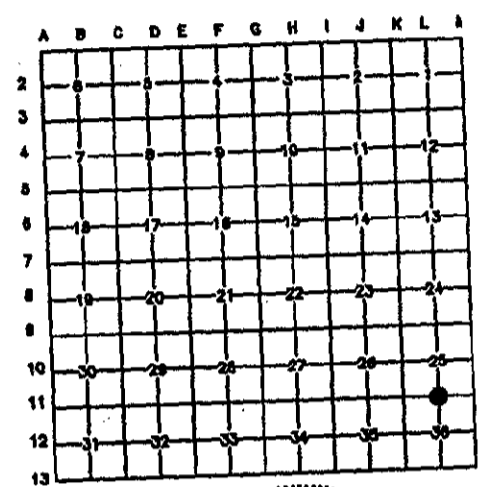


REVISITED 12-12-95  
DECEMBER 16, 1994

I, PAUL V. SCHWINNER, in a field survey on \_\_\_\_\_, do hereby certify that under requirements of P.A. 74, Michigan P.A. of 1970, the corner points mentioned in lines 1 and 2 above were in conformance with regulations and rules therefore as required in the current manual of survey instructions of the United States Department of the Interior, Bureau of Land Management or by decree of a Court of Law and/or that the corner points mentioned in lines 3, 4 and 5 above were in conformance with the rules of the Michigan Board of Land Surveyors or by Decree of a Court of Law; established, re-established, monumented, re-monumented, recovered, found as expressed below:

NOTE: Not more than 4 corners, all in the same town and range, may be recorded on this certificate

- A. Description of original monument and accessories and/or subsequent restoration:
- ORIG. GOVERNMENT NOTES 1815, WITNESSED BY BALESS JIMMINGS - SET POST (1)
  - WHITE OAK 18° S 55° E 71 LINKS (2)
  - WHITE OAK 26° N 55° E 15 LINKS (3)
  - WAYNE CO. BUREAU OF TAXATION (1930'S) IRON (4)
  - NLY. 21.54' "X" ON S. RING OF M.H. (5)
  - N.W. 46.70' IRON (6)
  - ELY. 5.00' 36" WILLOW (7)
  - SLY. 65.49' 12" LOCUST (8)
  - S.W. 80.00' 20" MAPLE (9)
  - N.W. 46.60' IRON (10)
  - BOARD OF WAYNE CO. RD. COMM IRON FOUND IN 1970 (4)
  - N.E. 65.05' MSHD TAG ON 12" ELM (11)
  - N.W. 46.45' PRDP MONUMENT (12)
  - S.E. 42.15' DE POLE (13)
  - N.W. 55.15' CENTER NUT ON HYDRANT (14)
  - ACT 132 SURVEY L.17980 PA.930 FND IRON 6" BELOW GROUND SURFACE BY ROBERT CAMPBELL RLS #13028 IN 1972 (4)
  - N.E. 39.98' SET P.K. S. SIDE 12" TREE (15)
  - S.E. 38.88' SET P.K. IN W. SIDE 8" MAPLED (16)
  - S.E. 73.80' SET P.K. IN N.E. SIDE M.B.T. POLE (17)

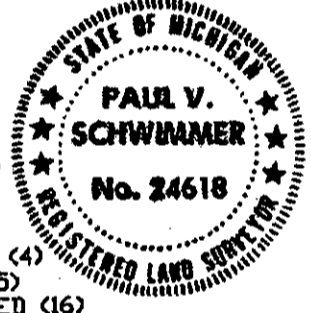

CONTINUED ON BACK

- B. Description of corner evidence and/or method applied in restoring or reestablishing corner:
- L-11  
THE FOLLOWING WITNESSES WERE RECOVERED:
- S 58° E 39.85' P.K. NAIL W/ WASHER "JCK RLS 24598 REF. PT. DO NOT DISTURB" IN S. SIDE P. POLE (19)
  - S 58° E 39.75' 16d NAIL W/ FLAGGING IN S.W. SIDE P. POLE (20)
  - S 30° W 111.58' P.K. NAIL IN W. SIDE P. POLE (21)
  - N 35° W 68.55' S.E. BUILDING CORNER, #40504 (19)
  - N 23° W 55.05' CENTERLINE TOP NUT ON FIRE HYDRANT (14)

- C. Description of monument for corner and accessories established to perpetuate locating the position of the corner:
- L-11  
FOUND 1/2" IRON ROD 1.0' DEEP IN GRAVEL ROAD
- N 16° E 84.15' P.K. NAIL W/ WASHER "JCK RLS 24598 REF. PT. DO NOT DISTURB" IN E. SIDE P. POLE (24)
  - N 16° W 83.59' 16d NAIL W/ FLAGGING IN E. SIDE P. POLE (22)
  - N 16° E 83.20' P.K. NAIL IN S.E. SIDE P. POLE (25)
  - N 45° E 46.68' 3/8" IRON ROD (23)
  - S 58° E 39.85' P.K. NAIL W/ WASHER "JCK RLS 24598 REF. PT. DO NOT DISTURB" IN S. SIDE P. POLE (19)
  - S 58° E 39.75' 16d NAIL W/ FLAGGING IN S.W. SIDE P. POLE (20)
  - S 30° W 111.71' P.K. NAIL W/ WASHER "JCK RLS 24598 REF. PT. DO NOT DISTURB" IN E. SIDE P. POLE (27)
  - S 30° W 111.58' P.K. NAIL IN W. SIDE P. POLE (21)
  - N 35° W 68.55' S.E. BUILDING CORNER, #40504 (19)
  - N 23° W 55.05' CENTERLINE TOP NUT ON FIRE HYDRANT (14)
  - DIST TO N.E. CORNER SECTION 36 2648.06' MEAS & 2649.46' REC IN 1930'S
  - DIST TO N.W. CORNER SECTION 36 2652.88' MEAS & 2652.59' REC IN 1930'S

WAYNE COUNTY REMONUMENTATION TAGS WERE PUT ON ALL APPROPRIATE WITNESSES AND REMONUMENTATION DISKS WERE PLACED ON THE PHYSICAL MONUMENT

THE SELECTED LOCATION IS ACCEPTED BY THE CONTRACTOR AND IS GENERALLY ACCEPTED BY PROFESSIONAL SURVEYORS AS THE BEST AVAILABLE EVIDENCE OF THE POSITION OF THE ORIGINAL CORNER.

Signed by Paul V. Schwinner Date 12-13-95

Surveyor's Michigan License No. 24618

4R

## ACT 74 SURVEY

1/2" REPROD BY S. AARON/C. FOX FOR JCK & ASSOCIATES INC.  
ON DECEMBER 15, 1994 (FIELD NOTES) (4)  
N 20° E 89.39' P.K. NAIL W/ WASHER IN E. SIDE P. POLE (18)  
N 25° W 58.58' S.E. CORNER OF BLDG, #40504 (19)  
S 30° E 39.85' P.K. NAIL W/ WASHER IN S. SIDE P. POLE (20)  
S 30° W 111.73' P.K. NAIL W/ WASHER IN E. SIDE P. POLE (21)

## ACT 132 SURVEY (OFFICE COPY)

FND STEEL BAR 1' BELOW GROUND SURFACE  
BY PETER PALCZYNSKI RLS #30096 IN 1995 (4)  
N 15° E 83.58' FND NAIL S.E. FACE UTILITY POLE (22)  
N 45° E 46.41' FND STEEL BAR ROW/ROW (23)  
S 60° E 39.76' FND NAIL S. FACE UTILITY POLE (20)  
S 15° W 111.62' SET P.K. NAIL W. FACE UTILITY POLE (21)  
N 30° W 68.59' S.E. CORNER BUILDING #40504 (19)

FILED DO NOT MAIL