

SURVEY & REMONUMENTATION

RC 1551

APR 25 1995

COMMISSION

LAND CORNER RECORDATION CERTIFICATE
Filing Requirement of Act 74, Mich. P.A. 1970

L127800PA041

For corners in

<u>WAYNE</u> (County)	Located In:	Corner Code #
1. Public Land Survey	T <u>1 S</u> R <u>8 E</u>	<u>M-1 NE COR SEC 1</u>
	T _____ R _____	_____
	T _____ R _____	_____
	T _____ R _____	_____
2. Property controlling in Section	S _____ T _____ R _____	_____
	S _____ T _____ R _____	_____
3. Miscellaneous Property in Sec.	S _____ T _____ R _____	_____
	S _____ T _____ R _____	_____
4. Lot No. _____, Recorded Plat _____		
5. Private Claims _____		

Compliance with ACT 345, P.A. 1990
APPROVED ON: 12-14-94 *DOJ*
WAYNE COUNTY REMONUMENTATION PEER GROUP COMMITTEE

Register of Deeds Stamp & File Number

	A	B	C	D	E	F	G	H	I	J	K
1											
2	6										
3											
4	7										
5											
6	8										
7											
8	9										
9											
10	10										
11											
12	11										
13											

I, PAUL V. SCHWIMMER, in a field survey on NOVEMBER 28, 19 94, do hereby certify that under requirements of P.A. 74, Michigan P.A. of 1970, the corner points mentioned in lines 1 and 2 above were in conformance with regulations and rules therefore as required in the current manual of survey instructions of the United States Department of the Interior, Bureau of Land Management or by decree of a Court of Law and/or that the corner points mentioned in lines 3,4 and 5 above were in conformance with the rules of the Michigan Board of Land Surveyors or by Decree of a Court of Law; established, re-established, monumented, re-monumented, recovered, found as expressed below:

NOTE: Not more than 4 corners, all in the same town and range, may be recorded on this certificate

A. Description of original monument and accessories and/or subsequent restoration:

M-1
NOVEMBER 1815 - *SET A POST FOR THE CORNER OF TOWNS 1 SOUTH & 1 NORTH, RANGES 8 & 9 EAST*
NO WITNESSES WERE RECORDED PER THE ORIGINAL NOTES WITNESSES CONTIN ON BACK

BUREAU OF TAXATION 1930'S FOUND MONUMENT (1) N.W. 39.85 TEL POLE (2) N.W. 48.77 MONUMENT (3) N.W. 143.20 16' TW. ELM (4) WEST 13.28 AXLE SHAFT W/GEAR (5) S.W. 31.90 'X' IN BASE OF POST (6) S.E. 48.76 MONUMENT (7)	BOARD OF WAYNE COUNTY RD. COMM 1974 FOUND MONUMENT IN MON. BOX (1) N.W. 165.45 'X' IN GUTTERLINE (8) Fd. WEST 200.00 P.K. NAIL @ STA 96 (9) S.W. 165.33 'X' IN GUTTERLINE (10) ATTACHED NOTE: *NOTE THIS INTERSECTION TO BE TORN UP DUE TO 1-96 CONSTRUCTION, FURTHER WIT'S MAY BE NEEDED.*
---	--


B. Description of corner evidence and/or method applied in restoring or reestablishing corner:

M-1
THE DIMPLED BRASS PLUG SET IN CONCRETE, LOCATED WITHIN A MONUMENT BOX, IS BEING ACCEPTED AS THE LOCATION OF THE COMMON CORNER OF TOWNSHIPS 1 SOUTH & 1 NORTH, AND TOWNSHIPS 8 EAST & 9 EAST BASED ON THE FOLLOWING INFORMATION:
* ALTHOUGH THE CORNER WAS POSSIBLY REMOVED DURING THE CONSTRUCTION OF 1-96, IT APPEARS THAT IT REMAINED INTACT, ALONG WITH WITNESS (9).
* NUMEROUS WITNESSES SHOW PERPETUATION OF THE CORNER SINCE 1974.
* THE DISTANCES SHOWN ON WITNESSES (21) AND (22) CONFIRM THE DISTANCES RECORDED IN THE BUREAU OF TAXATION SURVEY DONE IN THE 1930'S

\$ 16.00 MISCELLANEOUS RECORDING
28 DEC 94 8:17 A.M. RECEIPT# 4A
RECORDED
FOREST E. YOUNGBLOOD, REGISTER OF DEEDS

C. Description of monument for corner and accessories established to perpetuate locating the corner:

M-1 N.E. CORNER SECTION 1 TOWNSHIP 1 SOUTH, RANGE 8 EAST
FOUND MON IN BOX (DIMPLED BRASS PLUG SET IN CONCRETE) (17)
WEST 200.00 P.K. NAIL @ STA 96 (9) Fd.
N85°E 34.55 N.E. CORNER CATCH BASIN (14) Fd.
S80°E 33.34 N.E. CORNER CATCH BASIN (15) Fd.
SOUTH 3.65 BACK OF CURB (16) Fd.
SOUTH 32.65 'X' CUT IN TOP/CURB. (20) Fd.
N60°W 155.19 SET REMON. TAG IN N.E. SIDE POWER POLE
N55°E 115.33 SET REMON. TAG IN S.E. SIDE POWER POLE OVER EXISTING TAG LABELLED 'G.W.'
THE SELECTED LOCATION IS ACCEPTED BY THE CONTRACTOR AND IS GENERALLY ACCEPTED BY PROFESSIONAL SURVEYORS AS THE BEST AVAILABLE EVIDENCE OF THE POSITION OF THE ORIGINAL CORNER.

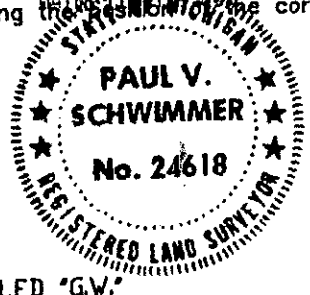

Signed by Paul V. Schwimmer
Surveyor's Michigan License No. 24618

Date 12-21-94 *2 R 14 D MIS*

1001008521

L127800PA042

ACT 132 SURVEY CS-1437 SHEET 1 OF 9, SEPT 27 1977
 GRANT WARD, R.L.S. MICHIGAN NO. 22445
 FOUND MONUMENT IN MONUMENT BOX (12) fd.
 N40°W 33.39 S.E. CORNER CATCH BASIN (13)
 N85°E 34.55 N.E. CORNER CATCH BASIN (14) fd.
 S80°E 33.34 N.E. CORNER CATCH BASIN (15) fd.
 SOUTH 3.65 BACK OF CURB (16) fd.

ACT 132 SURVEY CS-1437 SHEET 2 OF 9, SEPT 6 1977
 FOUND STAKE & CAP IN
 MONUMENT BOX (11)

ACT 132 SURVEY CS-1437 SHEET 3 OF 9, SEPT 6 1977
 FOUND STAKE & CAP IN
 MONUMENT BOX (11)

BOARD OF WAYNE COUNTY RD. COMM, JAN. 29, 1981
 FOUND MON IN BOX (DIMPLED BRASS PLUG SET IN CONCRETE) (17)
 N.E. 33.25 "X" CUT IN TOP/CURB @ CATCH BASIN (18)
 S.E. 32.31 "X" CUT IN TOP/CURB @ CATCHBASIN (19)
 SOUTH 32.61 "X" CUT IN TOP/CURB (20) fd.

ACT 132 SURVEY CS-1773, JUNE 14, 1982; FOUND MONUMENT BOX
 WILLIAM G. CARLSON, R.L.S. MICHIGAN NO. 14759
 WEST 2746.14 S 1/4 CORNER SECTION 36, T1N, R8E (21)
 SOUTH 2341.62 E 1/4 CORNER SECTION 1 (22) NOTE: SHEET 1 OF 3 OF CS-1773
 (L.21421, P.293) SHOWS THIS DISTANCE AS 2041.62, AN APPARENT TYPOGRAPHICAL
 ERROR.