SEQUENCE #2

LIBER 28482 PAGE 687

$ 4.00 REMONUMENTATION

$ 7.00 DEED

26 DEC 95 3:23 P.M. RECEI A

RECORDED

FOREST E. YOUNGBLOOD, REGISTER EDS

WAYNE COUNTY, MI

LAND CORNER RECORDATION CERTIFICATE

Filing Requirement of Act 74, Mich. P.A. 1970

For corners in WAYNE (County)

Located in: PLYMOUTH TWP.

Corner Code #

1. Public Land Survey — T 1 S R 8 E — M-9
2. Property controlling in Section
3. Miscellaneous Property in Sec.

Compliance with ACT 345, P.A. 1990

APPROVED ON: 12-13-95

WAYNE COUNTY REMONUMENTATION PEER GROUP COMMITTEE

Register of Deeds Stamp & File Number

SURVEY & REMONUMENTATION

APR 05 1996

COMMISSION

4. Lot No. _____, Recorded Plat _____
5. Private Claims _____

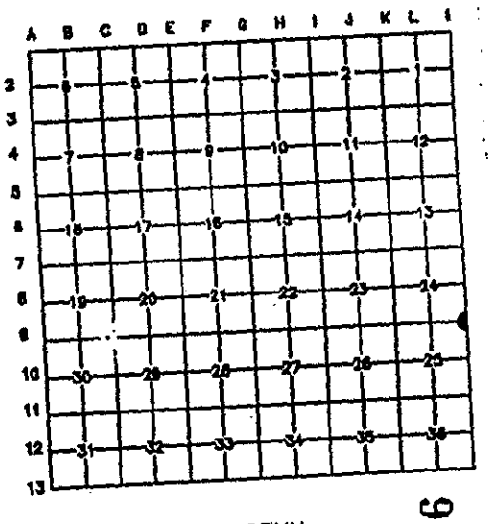

I, PAUL V. SCHWIMMER, in a field survey on NOVEMBER 15, 19 95, do hereby certify that under requirements of P.A. 74, Michigan P.A. of 1970, the corner points mentioned in lines 1 and 2 above were in conformance with regulations and rules therefore as required in the current manual of survey instructions of the United States Department of the Interior, Bureau of Land Management or by decree of a Court of Law and/or that the corner points mentioned in lines 3,4 and 5 above were in conformance with the rules of the Michigan Board of Land Surveyors or by Decree of a Court of Law; established, re-established, monumented, re-monumented, recovered, found as expressed below:

NOTE: Not more than 4 corners, all in the same town and range, may be recorded on this certificate

A. Description of original monument and accessories and/or subsequent restoration:

ORIG. GOVERNMENT NOTES 1815, WITNESSED
BY BALESS JIMMINGS - SET POST (1)
B.O. S43°E 93 LINKS (2)
B.O. N9°W 1 CHAIN 10 LINKS (3)
WAYNE CO. BUREAU OF TAXATION (1930'S)
MONUMENT (4)
E. 33.00 MONUMENT (5) S.W. 77.38 ED POLE (9)
S.E. 88.42 5" OAK (6) S.W. 58.53 MONUMENT (10)
S.E. 82.27 15" OAK (7) N.W. 45.76 40" OAK (11)
S. 32.02 MONUMENT (8)

BOARD OF WAYNE CO. RD. COMM
FND MON IN BOX 1970 (4)
S.E. 90.21 29" TWIN OAK (12)
S.E. 46.55 DE POLE (13)
S. 31.95 MONUMENT (8)
S.W. 45.95 DE POLE (14)
N.W. 74.43 DE POLE (15)

95274741

B. Description of corner evidence and/or method applied in restoring or reestablishing corner:

M-9 FOUND STEEL ENCASED CONCRETE MONUMENT 1.3' BELOW ROAD SURFACE. TWO WITNESSES REMAIN FROM THE 1930 RESURVEY EFFORT AND FOUR WITNESSESS REMAIN FROM THE 1970 WORK. AN ADDITIONAL DIST CHECK TO M-10 STRENGTHENS THE LOCATION OF THIS MONUMENT AS BEING THAT OF M-9.

M-9 IS NOT A COMMON CORNER WITH THE ADJACENT TOWNSHIP TO THE EAST

STATE OF MICHIGAN
PAUL V. SCHWIMMER
No. 24618
REGISTERED LAND SURVEYOR

C. Description of monument for corner and accessories established to perpetuate locating the position of the corner:

M-9 FOUND STEEL ENCASED MONUMENT 1.3' BELOW GROUND SURFACE
RAISED WITH 1/2" IRON AND SET MONUMENT BOX

A WAYNE CO. REMONUMENTATION WAS PLACED ON THE 1/2" IRON

N15°E 125.32 NAIL W/ W.C.R.C. TAG IN POWER POLE
N83°E 80.61 S.W CORNER BUILDING
S58°E 46.51 NAIL W/ W.C.R.C. TAG IN POWER POLE (13)
S51°W 45.70 NAIL W/ W.C.R.C. TAG IN POWER POLE (14)
N50°W 74.23 NAIL W/ W.C.R.C. TAG IN POLE (15)
N50°W 209.53 N.E. CORNER OF BRICK BUILDINGKDET EDISON SUBSTATION)
S00°W 31.95 CLOSING CORNER FOR A-9 OF LIVONIA TWP

DIST TO M-10 MEAS AT 2671.86 AND RECORDED AS 2672.23 FEET IN THE 1930'S RESURVEY EFFORT

THE SELECTED LOCATION IS ACCEPTED BY THE CONTRACTOR AND IS GENERALLY ACCEPTED BY PROFESSIONAL SURVEYORS AS THE BEST AVAILABLE EVIDENCE OF THE POSITION OF THE ORIGINAL CORNER.

Signed by Paul V Schwimmer

Date 12-15-95

Surveyor's Michigan License No. 24618

FORM APPROVED BY MICHIGAN STATE BOARD OF LAND SURVEYORS, JAN. 28, 1971
REVISED MAY 14, 1976
REVISED JAN., 1983

LR