

LAND CORNER RECORDATION CERTIFICATE  
Filing Requirement of Act 74, Mich. P.A. 1970

For corners in

WAYNE  
(County)

Located in: PLYMOUTH TWP

Corner Code #

- |                                    |   |            |   |            |             |
|------------------------------------|---|------------|---|------------|-------------|
| 1. Public Land Survey              | T | <u>1 S</u> | R | <u>8 E</u> | <u>M-11</u> |
|                                    | T | _____      | R | _____      | _____       |
|                                    | T | _____      | R | _____      | _____       |
|                                    | T | _____      | R | _____      | _____       |
| 2. Property controlling in Section | S | _____      | T | _____      | R           |
|                                    | S | _____      | T | _____      | R           |
| 3. Miscellaneous Property in Sec.  | S | _____      | T | _____      | R           |
|                                    | S | _____      | T | _____      | R           |

Compliance with  
ACT 345, P.A. 1990

APPROVED ON: 12-13-95 *DPJ*  
WAYNE COUNTY REMONUMENTATION  
PEER GROUP COMMITTEE

95274743

Register of Deeds Stamp & File Number

APR 05 1996

4. Lot No. \_\_\_\_\_, Recorded Plat \_\_\_\_\_
5. Private Claims \_\_\_\_\_ COMMISSION

	A	B	C	D	E	F	G	H	I	J	K	L
2												
3												
REVISITED ON 12-12-95

I, PAUL V. SCHWIMMER, in a field survey on FEBRUARY 08, 1995, do hereby certify that under requirements of P.A. 74, Michigan P.A. of 1970, the corner points mentioned in lines 1 and 2 above were in conformance with regulations and rules therefore as required in the current manual of survey instructions of the United States Department of the Interior, Bureau of Land Management or by decree of a Court of Law and/or that the corner points mentioned in lines 3, 4 and 5 above were in conformance with the rules of the Michigan Board of Land Surveyors or by Decree of a Court of Law; established, re-established, monumented, re-monumented, recovered, found as expressed below:

NOTE: Not more than 4 corners, all in the same town and range, may be recorded on this certificate

A. Description of original monument and accessories and/or subsequent restoration:

- ORIG. GOVERNMENT NOTES 1815, WITNESSED BY BALESS JIMMINGS - SET POST (1)
- BLACK OAK 6' N 86° E 31 LINKS (2)
- BLACK OAK 6' N 59° W 60 LINKS (3)
- WAYNE CO. BUREAU OF TAXATION (1930'S) STONE (4)
- N.W. 13.72' 5' OAK (5)
- ELY. 31.29' 12' ASH (6)
- N.W. 01.66' W.C.R. SIGN POST (7)
- N.W. 47.31' 20' OAK (8)

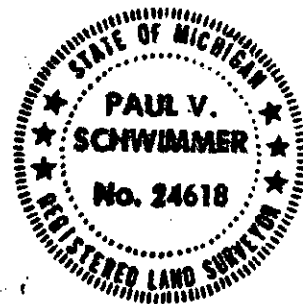

B. Description of corner evidence and/or method applied in restoring or reestablishing corner:

M-11  
PHYSICAL EVIDENCE OF THIS CORNER WAS NOT FOUND. ITS POSITION WAS RE-ESTABLISHED BY LOT RE-CONSTRUCTION OF 'TWIN ARBORS SUBDIVISION' AS RECORDED IN LIBER 88 OF PLATS, PAGES 84-85, WAYNE COUNTY RECORDS, WAYNE COUNTY, MICHIGAN

M-11 IS A COMMON CORNER WITH THE ADJACENT TOWNSHIP

\$ 4.00 REMONUMENTATION  
\$ 1.00 DEED

26 DEC 95 3:23 P.M. RECEI A  
RECORDED EDS  
FOREST E. YOUNGBLOOD, REGISTER  
WAYNE COUNTY, MI

C. Description of monument for corner and accessories established to perpetuate locating the position of the corner:

- M-11
- SET 1/2" X 18" IRON ROD WITH CAP
- N 05° E 14.25' SET NAIL & DISK IN W.SIDE 18' MAPLE
- N 85° E 27.72' SET NAIL & DISK IN N.SIDE 8' MAPLE
- S 45° W 34.90' SET NAIL & DISK IN SE.SIDE 20' OAK
- IRON SET AT INTERSECTION OF FENCE LINES EAST, WEST, & SOUTHEASTERLY
- DIST TO N 1/4 CORNER SECTION 36 2648.01' MEAS & 2649.46' REC IN 1930'S
- DIST TO E 1/4 CORNER SECTION 36 2664.88' MEAS & 2664.69' REC IN 1930'S

WAYNE COUNTY REMONUMENTATION  
TAGS WERE SET AT ALL APPROPRIATE  
WITNESSES AND REMONUMENTATION  
DISKS WERE PLACED ON THE  
PHYSICAL MONUMENT

THE SELECTED LOCATION IS ACCEPTED BY THE CONTRACTOR AND IS GENERALLY ACCEPTED BY PROFESSIONAL SURVEYORS AS THE BEST AVAILABLE EVIDENCE OF THE POSITION OF THE ORIGINAL CORNER.

Signed by Paul V. Schwimmer  
Surveyor's Michigan License No. 24618

Date 12-12-95

4R  
-1