

\$ 4.00 REMONUMENTATION

\$ 7.00 DEED

26 DEC 95 3:23 P.M.

RECEIVED

LAND CORNER RECORDATION CERTIFICATE

Filing Requirement of Act 74, Mich. P.A. 1976

REST E. YOUNGBLOOD, REGISTER
WAYNE COUNTY, MI

LIBER 28482 PAGE 688

For corners in

WAYNE

(County)

Located in:

PLYMOUTH TWP

Corner Code #

- 1. Public Land Survey T 1 S R 8 E M-12
- T _____ R _____
- T _____ R _____
- T _____ R _____
- 2. Property controlling S _____ T _____ R _____
- in Section S _____ T _____ R _____
- 3. Miscellaneous S _____ T _____ R _____
- Property in Sec. S _____ T _____ R _____

Compliance with
ACT 345, P.A. 1990

APPROVED ON: 12-13-95
WAYNE COUNTY REMONUMENTATION
PEER GROUP COMMITTEE

Register of Deeds Stamp & File Number

4. Lot No. _____, Recorded Plat APR 05 1996

5. Private Claims _____

COMMISSION

REVISITED 12-12-95

I, PAUL V. SCHWIMMER, in a field survey on JANUARY 30, 19 95, do hereby certify that under requirements of P.A. 74, Michigan P.A. of 1970, the corner points mentioned in lines 1 and 2 above were in conformance with regulations and rules therefore as required in the current manual of survey instructions of the United States Department of the Interior, Bureau of Land Management or by decree of a Court of Law and/or that the corner points mentioned in lines 3,4 and 5 above were in conformance with the rules of the Michigan Board of Land Surveyors or by Decree of a Court of Law; established, re-established, monumented, re-monumented, recovered, found as expressed below:

NOTE: Not more than 4 corners, all in the same town and range, may be recorded on this certificate

A	B	C	D	E	F	G	H	I	J	K	L	M
2												
3												
A. Description of original monument and accessories and/or subsequent restoration:


- ORIG. GOVERNMENT NOTES 1815, WITNESSED BY BALESS JIMMINGS - SET POST (1)
- WHITE OAK 24' N 04° E 26 LINKS (2)
- WHITE OAK 24' N 39° W 33 LINKS (3)
- WAYNE CO. BUREAU OF TAXATION (1930'S) IRON (4)
- N.E. 28.3' 4" CHERRY (5)
- N.E. 46.92' ED. POLE (6)
- SLY. 20.0' CROSS IN E. END HEADWALL (7)
- N.W. 63.93' 6" APPLE (8)
- NLY. 19.55' CROSS IN E. END HEADWALL (9)
- ACT 74 SURVEY L18911 PA204
- FND 1/2" PIPE IN MONUMENT BOX BY JAMES FRAUS IN 1974 (4)
- N 45° E 74.63' P.K. NAIL IN POWER POLE (10)
- S 47° E 73.59' P.K. NAIL IN POWER POLE (11)
- N 30° W 103.79' P.K. NAIL IN POWER POLE (12)
- ACT 132 SURVEY (OFFICE COPY) BY P. PALCZYNSKI LLS# 30096
- FND IRON PIPE IN MONUMENT BOX (4)
- N 45° E 74.54' SET NAIL IN S.E. FACE OF UTILITY POLE (10)
- S 45° E 73.41' FND NAIL IN S.W. FACE OF UTILITY POLE (11)
- S 50° W 102.52' CENTERLINE OF FIRE HYDRANT STEM (13)
- N 30° W 103.76' FND P.K. NAIL IN N.E. FACE UTILITY POLE (12)

B. Description of corner evidence and/or method applied in resturing or reestablishing corner:

M-12 IS COMMON CORNER WITH THE ADJACENT TOWNSHIP

THE FOLLOWING WITNESSES WERE RECOVERED:

- N 45° E 74.83' P.K. NAIL IN POWER POLE (10)
- N 45° E 74.66' NAIL AND TAG "REFERENCE POINT M.S.H.D." IN POWER POLE (10)
- S 42° E 73.24' NAIL AND TAG "REFERENCE POINT M.S.H.D." IN POWER POLE (11)
- N 30° W 103.76' P.K. NAIL IN WLY. SIDE OF POWER POLE (12)
- N 30° W 103.69' P.K. NAIL IN N.E. SIDE OF POWER POLE (12)

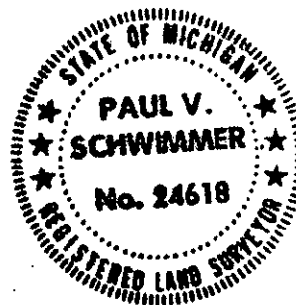

C. Description of monument for corner and accessories established to perpetuate locating the position of the corner:

- FND 1" IRON PIPE IN MONUMENT BOX AT CENTER LINE INTERSECTION ANN ARBOR ROAD AND ECKLES ROAD TO THE NORTH. (13)
- N 45° E 74.83' P.K. NAIL IN POWER POLE (10)
- N 45° E 74.66' NAIL AND TAG "REFERENCE POINT M.S.H.D." IN POWER POLE (10)
- S 42° E 73.24' NAIL AND TAG "REFERENCE POINT M.S.H.D." IN POWER POLE (11)
- N 30° W 103.76' P.K. NAIL IN WLY. SIDE OF POWER POLE (12)
- N 30° W 103.69' P.K. NAIL IN N.E. SIDE OF POWER POLE (12)

WAYNE COUNTY REMONUMENTATION TAGS WERE PUT ON ALL APPROPRIATE WITNESSES AND REMONUMENTATION DISKS WERE PLACED ON THE PHYSICAL MONUMENT

THE SELECTED LOCATION IS ACCEPTED BY THE CONTRACTOR AND IS GENERALLY ACCEPTED BY PROFESSIONAL SURVEYORS AS THE BEST AVAILABLE EVIDENCE OF THE POSITION OF THE ORIGINAL CORNER.

Signed by Paul V. Schwimmer

Date 12-13-95

Surveyor's Michigan License No. 24618

4R
7D