

SEQUENCE # 2

LIBER 28482 PAGE 687

\$ 4.00 REMONUMENTATION

\$ 7.00 DEED

LAND CORNER RECORDATION CERTIFICATE
Filing Requirement of Act 74, Mich. P.A. 1970
RECEIVED
RECORDED
FOREST E. YOUNGBLOOD, REGISTER
WAYNE COUNTY, MI

For corners in

WAYNE

(County)

Located in:
PLYMOUTH TWP.

Corner Code #

1. Public Land Survey

T LSRBE M-9

T _____

T _____

T _____

2. Property controlling
in Section

S _____ T _____ R _____

S _____ T _____ R _____

3. Miscellaneous
Property in Sec.

S _____ T _____ R _____

S _____ T _____ R _____

4. Lot No. _____, Recorded Plat _____

5. Private Claims _____

APR 05 1996

COMMISSION

Compliance with
ACT 345, P.A. 1990

APPROVED ON: 12-13-95
WAYNE COUNTY REMONUMENTATION
PEER GROUP COMMITTEE

Register of Deeds Stamp & File Number

	A	B	C	D	E	F	G	H	I	J	K	L	I
2													
3													
95274741

I, PAUL V. SCHWIMMER, in a field survey on NOVEMBER 15, 1995, do hereby certify that under requirements of P.A. 74, Michigan P.A. of 1970, the corner points mentioned in lines 1 and 2 above were in conformance with regulations and rules therefore as required in the current manual of survey instructions of the United States Department of the Interior, Bureau of Land Management or by decree of a Court of Law and/or that the corner points mentioned in lines 3, 4 and 5 above were in conformance with the rules of the Michigan Board of Land Surveyors or by Decree of a Court of Law; established, re-established, monumented, re-monumented, recovered, found as expressed below:

NOTE: Not more than 4 corners, all in the same town and range, may be recorded on this certificate

A. Description of original monument and accessories and/or subsequent restoration:


- ORIG. GOVERNMENT NOTES 1815, WITNESSED BY BALESS JIMMINGS - SET POST (1)
- B.D. S43°E 93 LINKS (2)
- B.D. N9°W 1 CHAIN 10 LINKS (3)
- WAYNE CO. BUREAU OF TAXATION (1930'S) MONUMENT (4)
- E. 33.00 MONUMENT (5) S.W. 77.38 ED POLE (9)
- S.E. 88.42 5° OAK (6) S.W. 58.53 MONUMENT (10)
- S.E. 82.27 15° OAK (7) N.W. 45.76 40° OAK (11)
- S. 32.02 MONUMENT (8)

BOARD OF WAYNE CO. RD. COMM
FND MON IN BOX 1970 (4)
S.E. 90.21 29° TWIN OAK (12)
S.E. 46.55 DE POLE (13)
S. 31.95 MONUMENT (8)
S.W. 45.95 DE POLE (14)
N.W. 74.43 DE POLE (15)

B. Description of corner evidence and/or method applied in restoring or reestablishing corner:

M-9 FOUND STEEL ENCASED CONCRETE MONUMENT 1.3' BELOW ROAD SURFACE. TWO WITNESSES REMAIN FROM THE 1930 RESURVEY EFFORT AND FOUR WITNESSES REMAIN FROM THE 1970 WORK. AN ADDITIONAL DIST CHECK TO M-10 STRENGTHENS THE LOCATION OF THIS MONUMENT AS BEING THAT OF M-9.

M-9 IS NOT A COMMON CORNER WITH THE ADJACENT TOWNSHIP TO THE EAST

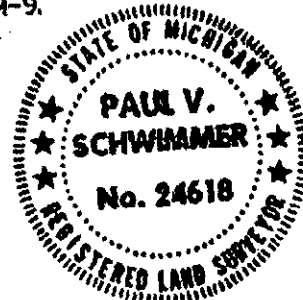

C. Description of monument for corner and accessories established to perpetuate locating the position of the corner:

- M-9 FOUND STEEL ENCASED MONUMENT 1.3' BELOW GROUND SURFACE RAISED WITH 1/2" IRON AND SET MONUMENT BOX
- N15°E 125.32 NAIL W/ W.C.R.C. TAG IN POWER POLE
- N83°E 80.61 S.W. CORNER BUILDING
- S58°E 46.51 NAIL W/ W.C.R.C. TAG IN POWER POLE (13)
- S51°W 45.70 NAIL W/ W.C.R.C. TAG IN POWER POLE (14)
- N50°W 74.23 NAIL W/ W.C.R.C. TAG IN POLE (15)
- N50°W 209.53 N.E. CORNER OF BRICK BUILDING (DET EDISON SUBSTATION)
- S00°W 31.95 CLOSING CORNER FOR A-9 OF LIVONIA TWP

A WAYNE CO. REMONUMENTATION
WAS PLACED ON THE 1/2" IRON

DIST TO M-10 MEAS AT 2671.86 AND RECORDED AS 2672.23 FEET IN THE 1930'S RESURVEY EFFORT
THE SELECTED LOCATION IS ACCEPTED BY THE CONTRACTOR AND IS GENERALLY ACCEPTED BY PROFESSIONAL SURVEYORS AS THE BEST AVAILABLE EVIDENCE OF THE POSITION OF THE ORIGINAL CORNER.

Signed by Paul V. Schwimmer
Surveyor's Michigan License No. 24618

Date 12-15-95

LR